


Section 9 Township 31 Range 14W

Well No. 1 Mills

Company Huber & Cities Service

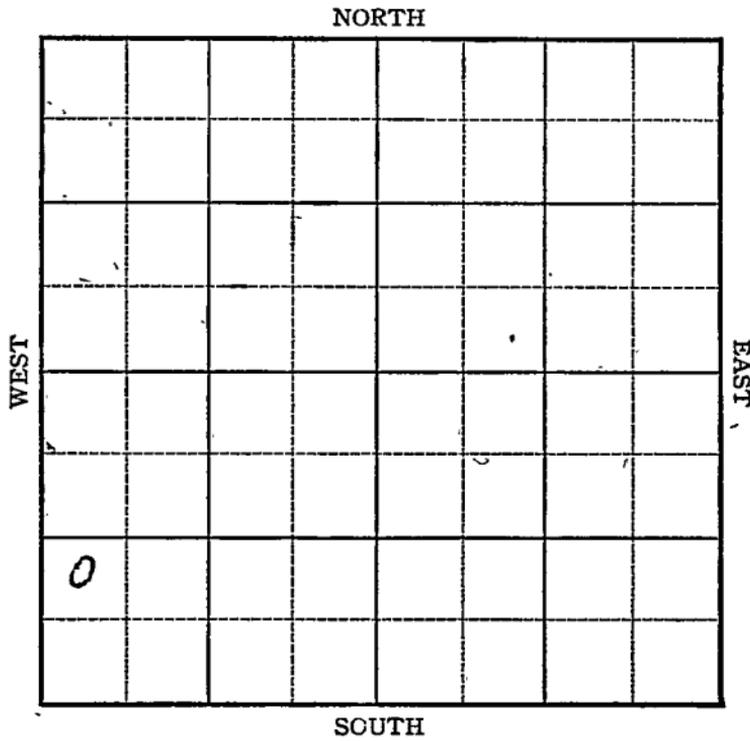



Sec. 9 Twp. 31 R. 14W

Well No. #1 Mills Farm

Huber & Cities Service Company

Skinner


.1667 Ft. from N. Line

_____ Ft. from S. Line

_____ Ft. from E. Line

330 Ft. from W. Line

NW SW SW

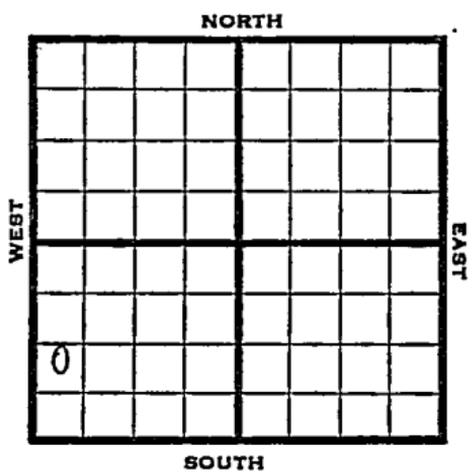

1946 Elev. 1629 REPORT

5/15 Derrick

5/21 15" @ 99 WOC

5/29 8" @ 798
Drlg. 2325'

6/5 Lens 3756
Drlg. 4135

6/12 Magwoketa 4344'
4370 TD
5" @ 4360' RUST

6/18 500 acid
Flow 40 oil PH 3 hrs.

6/26 Flowed 150 oil in 3 hrs.

7/3 " " "

7/10 Magwoketa 4344
5" @ 4360
500 acid.
TD 4370
Bomb Pot. 4418
Grav. 39.0

COMPLETED

Kansas Pool Name Skinner

Map No. KANSAS 73 Sec. 9 Twp. 31 R. 14W

Well No. 1 Mills

Huber & Cities Service Company

FIRST REPORT Contractor

NW SW SW 4

SECTION PLAT

1667 Ft. from N. Line

_____ Ft. from S. Line

_____ Ft. from E. Line

330 Ft. from W. Line

Barber County

Location _____

RECORD

Rig up _____

Cased _____ in., _____ ft.

Drilling and Remarks:

Sand _____

Terre de

Gas _____

Oil _____

Total Depth _____

PRODUCTION

1st 24 hrs. Nat. _____

1st 24 hrs. after shot _____

Gas _____ Cu. Ft.

Dry Hole _____

Abandoned _____

Date

MAY 15 1946

19

S. J. LEWIS

Scout

KANSAS Kansas Pool Name Skinner Pool

Map No. 23 Sec. 9 Twp. 31 R. 14W

Well No. 1 Mills

Huber & Cities Service Company

COMPLETED

Contractor

NW SW SW

E11627

SECTION PLAT

8			

1667 Ft. from N. Line

_____ Ft. from S. Line

_____ Ft. from E. Line

330 Ft. from W. Line

Barber County

Location _____

Rig up _____

Drilling and Remarks:

*Maguire to 4344
5-7 @ 4360
500 @ acid
Bonf P 1418*

139 @ 4e1

RECORD

Cased _____ in., _____ ft.

Sand _____

Gas _____

Oil _____

Total Depth 4370

PRODUCTION

1st 24 hrs. Nat. _____

1st 24 hrs. after shot _____

Gas _____ Cu. Ft.

Dry Hole _____

Abandoned _____

Date

JUL 10 1946 19

S. J. LEWIS

Scout