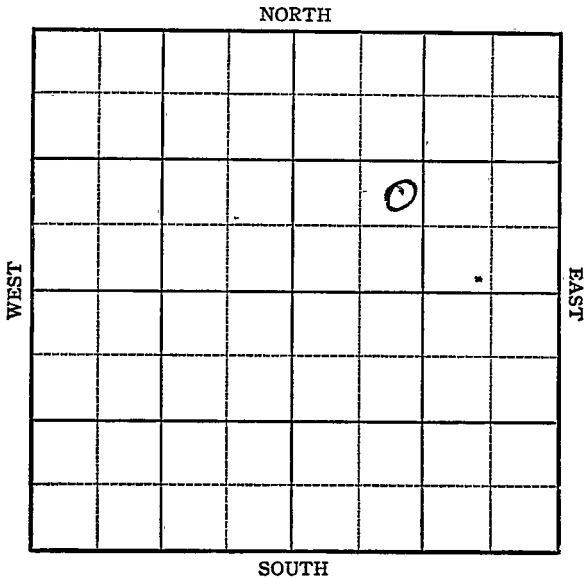


KANSAS

Barber County

FORM 51 5M PETROL

Section 9 Township 31 Range 14WWell No. 1 Roarck (Roark)Company Huber Oil

Sec. 9 Twp. 31 R. 14WWell No. 1 Roareck FarmHuber Oil Company

Wildcat

Ft. from N. Line

990


Ft. from S. Line

Ft. from E. Line

990

Ft. from W. Line

NE SW NE Elev. 1643

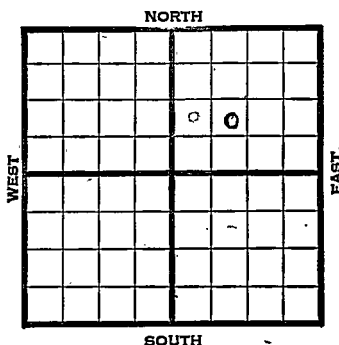

1945

REPORT

5/29

Location

6/8

Derrick

6/14

10" @ 803

WOC

6/21

Drlg. 3065

6/28

Douglas 3731

Lams 3749

TD 3753

7/3

TD 4348' Gas.

7/11

Viola 4374

Simp. 4447

Arb. 4563

TD 4590'

5" @ 4590' RUST

7/19

" " " "

7/26

24 shots 4359-4363

1750' oil 12 hrs.

8/1

" " "

8/8

" " "

8/15

" " "

8/22

" " "

8/29

500 acid.

Flow 45 oil in 2-3/4 hrs. 3 M Gas

9/5

" " " " " "

9/12

" " " " " "

9/19

" " " " " "

9/26

" " " " " "

10/3

" " " " " "

10/10

" " " " " "

10/17

" " " " " "

10/24

" " " " " "

OVER

1945

10/31	500 acid.				
	Flow 45 oil in 2-3/4 hrs.	3 M	Gas		
11/7	"	"	"	"	"
11/14	"	"	"	"	"
11/21	"	"	"	"	"
11/28	Magnoketa 4325				
	Arb. 4563				
	5" @ 4590				
	TD 4590				
	Perf. Magnoketa 500 acid.				
	Flow 124 Pot.				
	Grav. 40.0				

COMPLETED

Kansas Pool Name WildcatMap No. 73 Sec. 9 Twp. 31 R. 14WWell No. 1 RoarckHuber Oil


Company

FIRST REPORT

Contractor

NE SW NE

SECTION PLAT

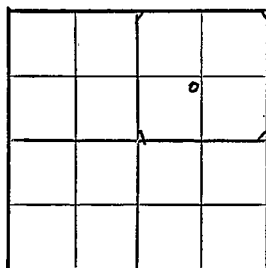 Ft. from N. Line990 Ft. from S. Line Ft. from E. Line990 Ft. from W. LineBarber CountyLocation XRig up

Drilling and Remarks:

RECORD

Cased in., ft.Sand Gas Oil Total Depth


PRODUCTION

1st 24 hrs. Nat. 1st 24 hrs. after shot Gas Cu. Ft.Dry Hole Abandoned

Date

MAY 29 1945 19S. J. LEWIS

Scout

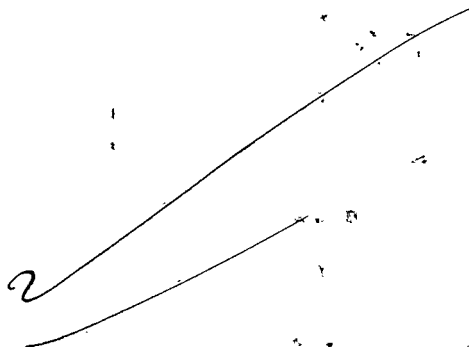

Misc. Small maps

Cards

Tracing

France Map

Scarborough Map

Pierce Map

Geological Dept.

Pierce Flat Book

KANSAS Kansas Pool Name HargisMap No. 93 Sec. 9 Twp. 31 R. 14WWell No. 1 RoarkHuber Oil Company

COMPLETED

Contractor

NE SW NE

F11643
SECTION PLAT

		Δ	

 Ft. from N. Line990 Ft. from S. Line Ft. from E. Line990 Ft. from W. Line

Barber County

Location Rig up

Drilling and Remarks:


RECORD

Cased in., ft.Sand Gas Oil Total Depth 4580

PRODUCTION

1st 24 hrs. Nat. 1st 24 hrs. after shot Gas Cu. Ft.Dry Hole Abandoned

Date

NOV 28 1945 19

S. J. LEWIS Scout

Misc. Small Maps

Cards

Tracing

France Map

Scarborough Map

Moody Map

Geological Dept.

Moody Map Book