


KANSAS

Barber

Section 9 Township 31 Range 14-W
Well No. #2 Rorak (Roark)
Company Huber

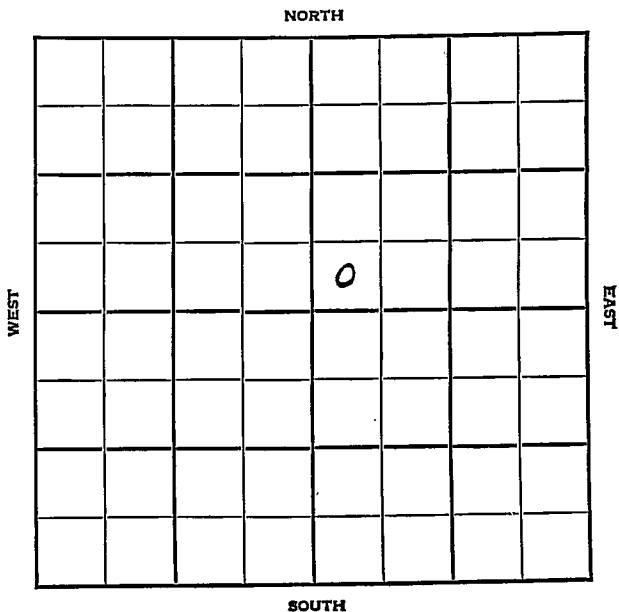

Barber

KANSAS

Sec. 9 Twp. 31 R. 14W ✓Well No. #2 Rorak Farm

Huber Company

Skinner Pool


Ft. from N. Line

330' Ft. from S. Line

Ft. from E. Line

330' Ft. from W. Line

SW NE

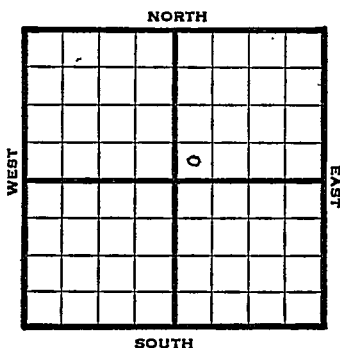

1948

Eli 1634'

REPORT

5/5 16" @ 125'
WOC

5/12 "

5/19 10" @ 800'
Drlg. 3940'5/26 Lansing 3741'
Viola 4317-22'
TD 4322'
5" @ 4319'
RUST

6/1 "

6/9 TD 4358'
Acid 5400'6/16 Flow 1 bbl oil PH
3½ M Gas

6/23 Flow 15 bbls oil 24 hrs - 1½ M gas

6/29 " "

7/8 " "

7/14 " "

7/21 TD 4358'
Viola 4317'
5" @ 4319'
5400 acid
Flow 1½ Oil Pot
39° Gr.
Comp.

COMPLETED

Map No. _____ Sec. 9 Twp. 31 R. 14WWell No. 2 Rorak

_____ Huber _____ Company

FIRST REPORT

_____ Contractor

SW NE

SECTION PLAT

_____ Ft. from N. Line

330 Ft. from S. Line

_____ Ft. from E. Line

330 Ft. from W. Line

		o	

Barber County

Location _____

Rig up _____

Drilling and Remarks:

16" @ 125 WOC

RECORD

Cased _____ in., _____ ft.

Sand _____

Gas _____

Oil _____

Total Depth _____

PRODUCTION

1st 24 hrs. Nat. _____

1st 24 hrs. after shot: _____

Gas _____ Cu. Ft.

Dry Hole _____

Abandoned _____

Date

MAY 5 1948 19 S. J. LEWIS Scout

Map No. 93 Sec. 9 Twp. 31 R. 14W

Well No. 2 Rorak

Huber Company

COMPLETE

Contractor

SW NE

E 11634
SECTION PLAT

		2	

 Ft. from N. Line

330 Ft. from S. Line

 Ft. from E. Line

330 Ft. from W. Line

Barber County

Location

Rig up

Drilling and Remarks:

Vid 4317

5" C 4318

5400 acic

Flow 14 oil

39 2/3

RECORD

Cased in., ft.

Sand

Gas

Oil ✓

Total Depth 4358

PRODUCTION

1st 24 hrs. Nat.

1st 24 hrs. after shot

Gas Cu. Ft.

Dry Hole

Abandoned

Date

JUL 21 1948

19

S. J. LEWIS

Scout



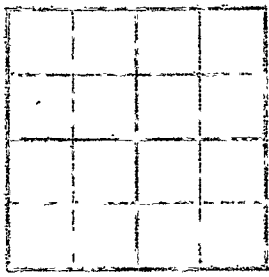



Misc. Small Maps	_____
Cards	_____
Tracing	_____
France Map	_____
Scarborough Map	_____
Pierce Map	_____
Geological Dept.	_____
Pierce Plat Book	_____




