

KANSAS


FORM 51 5M 6-46 PETROL

Barber County

Section 9 Township 31 Range 14W

Well No. #2 Skinner

Company Driller's Gas

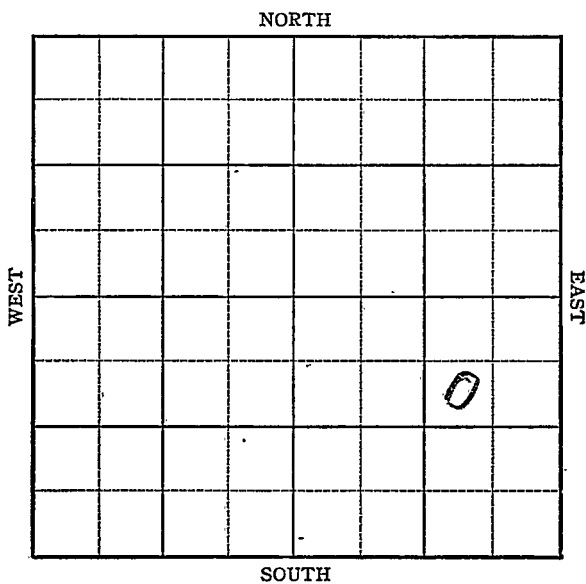

KANSAS

Barber County

Sec. 9 Twp. 31 R. 14W

Well No. #2 Skinner Farm

Driller's Gas Company

Skinner


990 Ft. from N. Line

 Ft. from S. Line

990 Ft. from E. Line

 Ft. from W. Line

SW NE SE

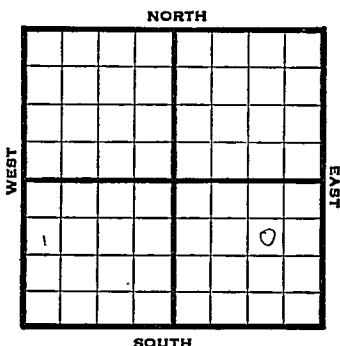

1946

1628

REPORT

7/17 RUR
7/23 20" @ 20'
16" @ 68'
12" @ 261 WOC
7/30 8" @ 785
Drlg 2925'
8/6 Drlg 4145'
8/13 Mag. 4325
4327 TD
5" @ 4326 RUST
8/20 " "
8/27 " "
9/5 4329 fsg
9/10 " "
9/18 " "
9/24 TD 4366'
2000 acid, swb 22 oil in 6 hrs
10/1 Drlg 4388'
10/8 " "
10/15 " "
10/23 Viola 4382'
TD 4407'

ABANDONED

KANSAS Pool Name Skinner
 Map No. Q3 Sec. 9 Twp. 31 R. 14W
 Well No. 2 Skinner

Driller's Gas _____ Company _____

FIRST REPORT

Contractor _____

SW NE SE

SECTION PLAT

			o

990 Ft. from N. Line

_____ Ft. from S. Line

990 Ft. from E. Line

_____ Ft. from W. Line

Barber County

Location _____

Rig up _____

Drilling and Remarks:

R U R

RECORD

Cased _____ in., _____ ft.

Sand _____

Gas _____

Oil _____

Total Depth _____

PRODUCTION

1st 24 hrs. Nat. _____

1st 24 hrs. after shot _____

Gas _____ Cu. Ft.

Dry Hole _____

Abandoned _____

Date

JUL 17 1946 19 _____ S. J. LEWIS Scout

St. Paul

for the

2

aps

[Signature]

ing

ance Map

Scarborough Map

Pierce


Map No. 93 Sec. 9 Twp. 31 R. 14WWell No. 2 SkinnerDriller's G. S.

Company

ABANDONED

Contractor

SW NE SE

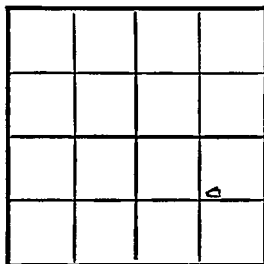E. 11628
SECTION PLAT990 Ft. from N. Line Ft. from S. Line990 Ft. from E. Line Ft. from W. Line

Barber County

Location Rig up

Drilling and Remarks:

Vista 4382

RECORD

Cased in., ft.Sand Gas Oil Total Depth 4407

PRODUCTION

1st 24 hrs. Nat. 1st 24 hrs. after shot Gas Cu. Ft.Dry Hole Abandoned

Date


OCT 23 1946

19

S. J. LEWIS

Scout

1-10 1/2

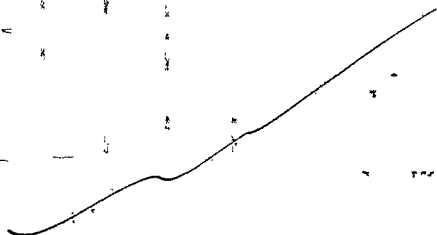

Ch

Misc. Small Maps	<i>Ch</i>
Cards	<i>Saul</i>
Tracing	<i>MT</i>
France Map	<i>✓</i>
Scarborough Map	<i>✓</i>
Elanco Map	<i>✓</i>
Geological Dept.	<i>✓</i>
Pierce Flat Book	<i>✓</i>