

Barber

KANSAS

SECTION 9 TOWNSHIP 31 RANGE 10 W

WELL NO. #1 Morisse

COMPANY K & E Drlg.

NORTH

					0		

WEST

EAST

SOUTH

Barber

KANSAS

SEC.	TWP.	R.
9	31	10W

WELL NO.

#1 Morisse

FARM

COMPANY

K&E Drlg.

CONTRACTOR

Co. Tools

WILDCAT


Ft. from N. Line

Ft. from S. Line

Ft. from E. Line

Ft. from W. Line

NE NW NE

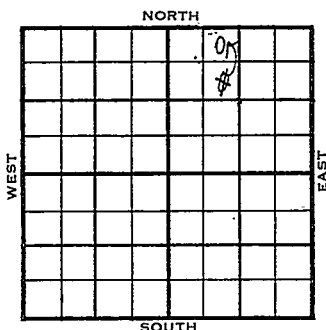

Mag. AC - Sinc. DHM

	ELEVATION	REPORT
1956	1773 RB, 1770 DF	
1-25	Comm. 1-18-56 8" @ 306/225 Drlg. 3085	
2-8	D & A H. 3674 Tonga 3809 L. 3868 M. 4497 K. 4608 Chata 4698 V. 4728 S. 4808 S.Sd. 4819 A. 4920 TD 4950	

ABANDONED

1773 RB

County Barber Elev. 1770 DF
 Sec. 9 Twp. 31 Rge. 10W
 Company K & E Drilg.
 Farm Name Morisse No. 1

TOPS

DEPTH

LOG

DATUM

Anh.

Tp.

H.

Tr.

Dg.

Bl.

L.

K.C.

B.K.C.

Ce.

C.

M.

M.

K.

Mz.

Ma.

V.

S.

S.

A.

R.

P.E.

G.

T.D.

Loc. in Sec.

NE NW NE

Geol.

Contr.

Co. tools

Pool

Wildcat



Date Comm. 1-18-56 Mag. AC - Sinc. DHM
8" @ 306/225 drilg. 3085

27

1773 RB

County Barber Elev. 1770 DF
 Sec. 9 Twp. 31 Rge. 10W
 Company K & E Drilg.
 Form Name Mariassa No. 1

TOPS	DEPTH	LOG	DATUM	Loc. in Sec.
				NE NW NE
TP				
H	3674			
Tc	3809			
By				
SI				
L	3868		2098	Geol.
NC				
RC				Contc
Ce.				Co. tools
C	4497		2729	Pool
M				
R	4608		2838	Wildcat
chato	4798		2988	
V	4728		2958	
SD	4808		3038	
	4819		3049	
	4920		3150	
	4950			

ABANDONED
 FEB 8 1956

Basic Comm. 1-28-56 Mag. AC - Sinc. DEM

8" @ 306/225 drilg. 3085 FEB 1 '56

DST 4296-4317 1hr sec 40' Md
 (Rainbow) BHP 1340 DST 4493
 -4510 1hr sec 100' 934 Md
 BHP 280 ID 4510 FEB 8 '56 DST
 4724-33 1hr sec 90' Mud BHP
 105'

10' 8" 0