

Barber
31

O.W.W.O.
KANSAS

11W

Section 9 Township _____ Range _____

Well No. #1 Smith

Company Musgrove Petr. Carl Todd

NORTH

					0		

WEST

EAST

SOUTH

O.W.W.O.

Barber

KANSAS ✓

Sec. 9 Twp. 31 R. 11WWell No. #1 Smith FarmMusgrove Pet. Carl Todd CompanyMusgrove Contractor

Wildcat

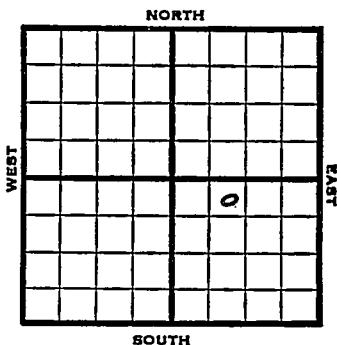
330 Ft. from N. Line

Ft. from S. Line

Ft. from E. Line

990 Ft. from W. Line

NE NW SE

SDX $\frac{1}{2}$ mile.

1953 Elev. 1817' REPORT

5/27 Spud 5-25-53
Drlg 550'6/3 8" @ 308
Drlg. 3185'6/10 Elgin Zone 3646 Heeb 3753
B. Oread 3790 Doug 3826
DST 3828-50, 1 hr, 1360' SW
1275# Lans 3952
Drlg. 41696/24 Spud 5-25-53
D&A
TD 4885
8" @ 308
Elgin zone 3646, Heeb 3753, B Oread
3790, Doug 3826
DST 3828-50, opn 1 hr., rec. 1360'
sw, 1275#
Lans 3952, Miss 4506
DST 4536-49, opn 1 hr., rec. 10' mud,
Viola 4790, Simp 4860
DST 4861-83, opn 1 hr., gas in 6 mins
Rec. 533' sw, 745#
TD 4885
D&A

ABANDONED

OVER

1956

O.W.W.O.

2-22 OTD 4885
DD 4940
5 $\frac{1}{2}$ " @ 4938
L. 2952
M. 4506
V. 4790
S. 4865

3-1 CO to 4908
16/4864-68, 5,216 mcfg, 1525#

3-8 1599 mcfg, 4 bwph,
F/ 500 mcfg, 1.3 boph

3-15 No report

3-22 "

3/28 L 3952
M 4506
V 4790
S 4865
TD 4885
DD 4940 5 1/2" @ 4938 CO to 4908
16/4864-68 5,216 mcfg
Comp SI gas well F/500 MCF 1.3 boph

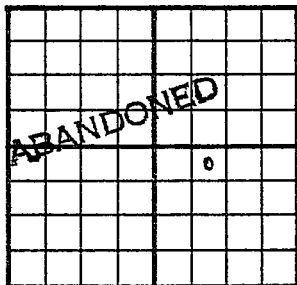
COMPLETED

J. G. McGEHEE

Scout Cards	
Land Small Map	
Land Wall Map	
Tracings	
France Map	
Pierce Map	
Misc.	

JUN 1 1953

Kansas

County Barber State KansasSec. 9 (Blk.) 31 (Sur.) 11W (Twp.) 11W Map No.Operator Musgrove Pet.Well No. 1 Farm SmithElev. 1817 Location NE NW SE330 Ft. From N Line SE990 Ft. From W Line Quarter

1st. Report

Completion JUN 24 1953Remarks WildcatMusgrove - Contr.Spudding Date 5-25-53Drlg. Data D & A TD 48858" @ 308 Elgin zone 3646 Heeb. 3753B. Oread 3790 Doug. 3826 DST 3828-50open 1 hr. Rec. 1360' sw 1275#Lans. 3952 Miss. 4506 DST 4536-49open 1 hr. Rec. 10' mud Viola 4790Simp. 4860 DST 4861-83 open 1 hr.gas in 6 min. Rec. 533' sw 745#TD 4885D & A

J. G. McGEHEE

JUN 30 1953

Scout Cards	_____
Land Small Map	_____
Land Wall Map	_____
Tracings	_____
France Map	_____
Florce Map	_____
Misc.	_____

O.W.W.O.

OWWO

FORM 513 REV. SUNRAY

County Barber Elev. 1817
 Sec. 9 Twp. 31 Rge. 11W
 Company Carl Todd (was Musgrove)
 Farm Name Smith No. 1

TOPS	DEPTH	LOG	DATUM	Loc. in Sec.
Anh.				NE NW SE
Tr.				
Dg.				
Bl.				
L.	3952			Geol.
K.C.				Contr.
B.K.C.				D & M
Ce.				Pool
C.	4506			Wildcat
M.				
M.				
K.				
Mz.				
Mq.				
V.	4790			
S.	4865			
S.				
A.				
R.				
PE.				
G.				
T.D.	4885			

1/2 mile
 FIRST REPORT
 FEB 22 '56

Date Comm.

DD 4940 5^{1st} @ 4938

MAR 1 1954

R. G.

County Barber Elev. 1817
 Sec. 9 Twp. 31 Rge. 11W
 Company Carl Todd (was Musgrove)
 FarmName Smith No. 1

TOPS

DEPTH

LOG

DATUM

Loc. in Sec.

Anh. NE NW SE






L. 3952 2135

K.C. Geol.

B.K.C. Contr.

Ce. D & M


M. 4506 2689





V. 4790 2973

S. 4865 3048






T.D. 4885

COMPLETE
 MAR 25 '56

Date Comm.

DD 4940 5 1/2" @ 4938 CO to 4908

16/ 4864-68 5,216 mcfg

Comp. SI gas well F/ 500 mcfg 1.3 boph

APR 6 1956

M. MC.