


Section 9 Township 31 Range 34W

Well No. #1 Meyers

Company F. C. Koch

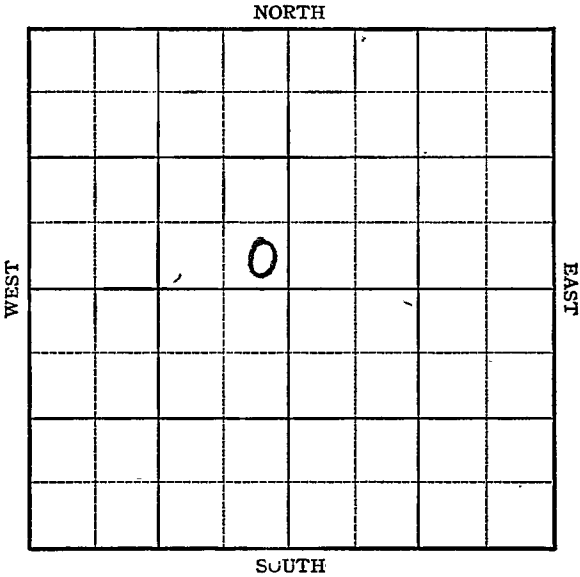

Sec. 9 Twp. 31 R. 34W

Well No. #1 Meyers Farm

F. C. Koch Company


Hugoton

         Ft. from N. Line

200 Ft. from S. Line

200 Ft. from E. Line

         Ft. from W. Line

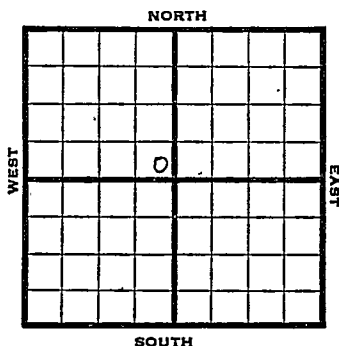

SE NW

1946 Elev. 2837 REPORT

2/6	Location
2/14	"
2/21	"
2/28	10" - 487' Drlg. 1520'
3/7	Drlg. 2327'
3/14	T.D. 2469'
	7" - 2460' RUST.
3/21	" " "
3/28	" " "
4/4	Drlg. 2525
4/10	TD 2650
	240' of 5" Perf
	Liner @ 2650
	7000 acid
4/16	8000 acid
4/23	8000 acid
5/1	" "
5/7	" "
5/14	" "
5/21	" "
5/29	" "
6/5	" "
6/12	" "
6/18	" "
6/26	" "
7/3	" "
7/9	" "

OVER

1946

7/17 7" @ 2460  
240' of 5" perf. liner  
15,000 acid.  
TD 2650'  
5,814,000 Gas.  
396<sup>#</sup> R Pr.

COMPLETED

**KANSAS**

Kansas

Pool Name

Hugoton

Map No. *None*

*None*

Sec. 9

Twp. 31

R. 34W

Well No. 1 Meyers

F.C. Koch

Company

FIRST REPORT

Contractor

SE NW

SECTION PLAT

\_\_\_\_\_ Ft. from N. Line

200 Ft. from S. Line

200 Ft. from E. Line

\_\_\_\_\_ Ft. from W. Line

		0	

Seward County

Location X

Rig up \_\_\_\_\_

Drilling and Remarks:

RECORD

Cased \_\_\_\_\_ in., \_\_\_\_\_ ft.

Sand \_\_\_\_\_

Gas \_\_\_\_\_

Oil \_\_\_\_\_

Total Depth \_\_\_\_\_

PRODUCTION

1st 24 hrs. Nat. \_\_\_\_\_

1st 24 hrs. after shot \_\_\_\_\_

Gas \_\_\_\_\_ Cu. Ft.

Dry Hole \_\_\_\_\_

Abandoned \_\_\_\_\_

Date

FEB 6 1946

19

S. J. LEWIS

Scout

no work

*[Handwritten signature]*

Misc. Small Maps	<del>11/11</del>
Cards	<i>Sarah</i>
Tracing	.....
France Map	.....
Scarborough Map	.....
Moody Map	.....
Geological Dept.	.....
Moody Plat Book	.....

Kansas Pool Name Hugoton

Map No. KANSAS 73M Sec. 9 Twp. 31 R. 34W

Well No. 1 Meyers

F. C. Koch Company

**COMPLETED**

Contractor

SE NW

*E 1,2837*  
SECTION PLAT

	0		

\_\_\_\_\_ Ft. from N. Line  
200 Ft. from S. Line  
200 Ft. from E. Line  
 \_\_\_\_\_ Ft. from W. Line

Seward County

Location \_\_\_\_\_

Rig up \_\_\_\_\_

Drilling and Remarks:

*7" @ 2460*  
*240' of 5" Perf. lined*  
*15000 acid*  
*5,814,000 Gas*  
*896 # RA*

**RECORD**

Cased \_\_\_\_\_ in., \_\_\_\_\_ ft.  
 Sand \_\_\_\_\_  
 Gas \_\_\_\_\_  
 Oil \_\_\_\_\_  
 Total Depth 2650

**PRODUCTION**

1st 24 hrs. Nat. \_\_\_\_\_  
 1st 24 hrs. after shot \_\_\_\_\_  
 Gas \_\_\_\_\_ Cu. Ft.  
 Dry Hole \_\_\_\_\_  
 Abandoned \_\_\_\_\_

Date

JUL 17 1946 19

S. J. LEWIS Scout

NOV 1911

*no well*

Disc. Small Maps	<input checked="" type="checkbox"/>
Cards	<input checked="" type="checkbox"/>
Tr. 3	<input checked="" type="checkbox"/>
France Map	<input checked="" type="checkbox"/>
Scarborough Map	<input checked="" type="checkbox"/>
Pierce Map	<input checked="" type="checkbox"/>
Geological Dept.	<input type="checkbox"/>
France Plat. Book	<input type="checkbox"/>