Meade KANSAS

9 31 29W


SECTION TOWNSHIP RANGE

#1 Budde "A" "B"

WELL NO.

Northern Nat'l ~~& Atlantic~~

COMPANY

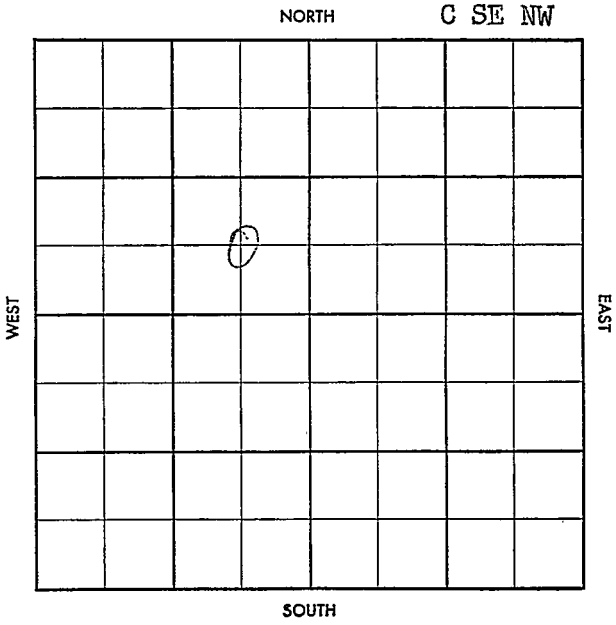

FORM 504-3 SUNRAY

23

S-513-A

CO. Meade ELEV.

SEC. 9 TWP. 31 RGE. 29W

COMPANY Northern Nat. & Atlantic NO. 1

SEP 25 57

FIRST REPORT

FARM Budde "A"

LOC. C SE NW 1992' WL 3318' SL

GEOL.

CONTR. Gabbert

POOL Hockett

SPUD 9-23-57

drlg. 680

CO. LSE. NO. SEC. TWP. RGE.

K 23

C[illegible] -N

13

title

S-513-A

CO. Meade ELEV. 2736

SEC. 9 TWP. 31 RGE. 29W

COMPANY Northern Nat. NO. 1

~~Atlantic~~

FARM Budde "B"

LOC. C SE NW 1992' WL 3318' SL

ABANDONED

OCT 23 '57

GEOL.

CONTR. Gabbert

POOL Pocket

SPUD 9-23-57

drlg. 680

8 5/8 1709/1100

D 2710 D 3120

D 4736

rd 5395

-5430 35' ve

Hol 2644

Hen 2710

8' lime dense crys 6' shale
1' lime tan dense 1' shale green
green 2' lime tan dense 5'
sh gr green limy 12' lime
dense hard rd 5430-45
15' 2' lim den crys hard NS
12' shale 8" lime 4" shale
DST 5388-5445 60" 3'M FP
45# BHP 45/20 TD 5615

Log Tops

Hr 2684 Win 2792 UFTR 2
2846 Penn 3614 Hb 4324
TR 4344 Lsg 4443 Marm
5018 Ce 5178 Mor 5400
M 5416 St Gen 5590

D & A