

Section 9 Township 31 Range 32WWell No. #1 McCuneCompany Northern Ordnance

NORTH

|  |  |  |   |  |  |  |  |
|--|--|--|---|--|--|--|--|
|  |  |  |   |  |  |  |  |
|  |  |  |   |  |  |  |  |
|  |  |  |   |  |  |  |  |
|  |  |  | 0 |  |  |  |  |
|  |  |  |   |  |  |  |  |
|  |  |  |   |  |  |  |  |
|  |  |  |   |  |  |  |  |
|  |  |  |   |  |  |  |  |

WEST

EAST

SOUTH

Seward

KANSAS



Sec. 9 Twp. 31 R. 32 W

Well No. # 1 McCune Farm

Northern Ordnance Company

Hugoton Pool

Contractor


Ft. from N. Line

330 Ft. from S. Line

330 Ft. from E. Line

Ft. from W. Line

SE SE NW

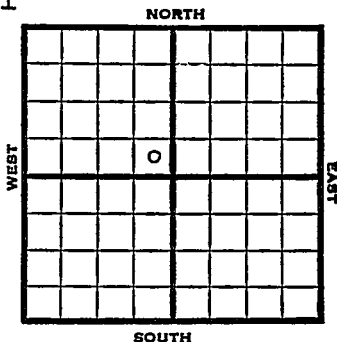

1951

Elev. 2862'

REPORT

5/9


Drlg.

7/11

Gas well TD 2705' 10" @ 607  
7" @ 2599 TD 2656' 1000 A  
DD 2705' 3000 A Win 2687'  
Comp. 6,800,000 gas 385#  
17,000 A

**COMPLETED**

J. E. TYRA

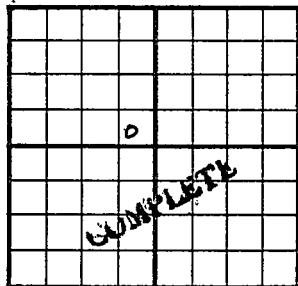County Seward State KansasSec. 9 (<sup>Blk.</sup><sub>Twp.</sub>) 31 (<sup>Sur.</sup><sub>Rge.</sub>) 32W Map No.Operator Northern OrdnanceWell No. 1 Farm McCuneElev. 2862 Location SE SE NW330 Ft. From S Line NW330 Ft. From E Line Quarter

1st. Report

Completion JUL 1 1951Remarks Hugoton Pool

Spudding Date

Drlg. Data Gas well TD 270510" @ 607 7" @ 2599 TD 26561000 A DD 2705 3000 AWin. 2687 Comp. 6,800,000 gas 385#17000 A

J. E. TYRA