

SECTION 9 TOWNSHIP 31S RANGE 4W

WELL NO. #1-McDaniels

COMPANY Richard King, Jr.

NW SE NW

NORTH

WEST

EAST

|  |  |   |  |  |  |  |  |
|--|--|---|--|--|--|--|--|
|  |  |   |  |  |  |  |  |
|  |  |   |  |  |  |  |  |
|  |  | 0 |  |  |  |  |  |
|  |  |   |  |  |  |  |  |
|  |  |   |  |  |  |  |  |
|  |  |   |  |  |  |  |  |
|  |  |   |  |  |  |  |  |
|  |  |   |  |  |  |  |  |

SOUTH

SEC.

9

TWP.

31 S

R.

4 W

WELL NO.

# 1 McDaniels

FARM

COMPANY

Richard King, Jr.

CONTRACTOR

McKnab &amp; Lindsay

Wildcat


\_\_\_\_\_ FT. FROM N. LINE

\_\_\_\_\_ FT. FROM S. LINE

\_\_\_\_\_ FT. FROM E. LINE

\_\_\_\_\_ FT. FROM W. LINE

NORTH

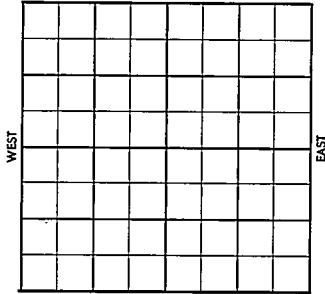

NW SE NW

SDX-3/4 Mile

ELEVATION

1957

REPORT

7/17

Comm. 7-14-57  
Drlg. 1250'

(FR Tkt)

## WILDCAT

County Sumner Elev. \_\_\_\_\_  
 Sec. 9 Twp. 31 Rge. 14W  
 Company Richard King, Jr.  
 Farm Name McDaniels No. 1

Co.

| TOPS   | DEPTH | LOG | DATUM |
|--------|-------|-----|-------|
| Anh.   |       |     |       |
| Tp.    |       |     |       |
| H.     |       |     |       |
| Tr.    |       |     |       |
| Dg.    |       |     |       |
| Bl.    |       |     |       |
| L.     |       |     |       |
| K.C.   |       |     |       |
| B.K.C. |       |     |       |
| Ce.    |       |     |       |
| C.     |       |     |       |
| M.     |       |     |       |
| M.     |       |     |       |
| K.     |       |     |       |
| Mz.    |       |     |       |
| Ma.    |       |     |       |
| V.     |       |     |       |
| S.     |       |     |       |
| S.     |       |     |       |
| A.     |       |     |       |
| R.     |       |     |       |
| Pe.    |       |     |       |
| G.     |       |     |       |
| T.D.   |       |     |       |

Loc. in Sec. \_\_\_\_\_

NW SE NW

Geol. \_\_\_\_\_

Contr. \_\_\_\_\_

McKnaab &amp; Lindsay

Pool \_\_\_\_\_

Wildcat

FIRST REPORT

JUL 17 '57

L.S.

No.

Sec.

T.

R.

Date Comm. 7-11-57

drlg. 1250

M

FORM 513 SUNRAY

 Sec. 9 Rge. 4W  
 Company Richard Kin, Jr.  
McDaniels No. 1

|        | DEPTH | LOG | DATUM | Loc. in Sec. |
|--------|-------|-----|-------|--------------|
| And.   |       |     |       | NW 1/4       |
| Tr.    |       |     |       |              |
| H.     |       |     |       |              |
| Tr.    |       |     |       |              |
| Dg.    |       |     |       |              |
| BL     |       |     |       |              |
| L.     |       |     |       | Geol.        |
| K.C.   | 3482  |     |       | Contr.       |
| B.K.C. |       |     |       | McKrab 1 Lin |
| Ce.    |       |     |       | Pool         |
| C.     |       |     |       | Wildcat      |
| M.     |       |     |       |              |
| M.     |       |     |       |              |
| K.     |       |     |       |              |
| Mz.    |       |     |       |              |
| Me.    |       |     |       |              |
| V.     |       |     |       |              |
| S.     |       |     |       |              |
| S.     |       |     |       |              |
| A.     |       |     |       |              |
| R.     |       |     |       |              |
| Pe.    |       |     |       |              |
| G.     |       |     |       |              |
| T.D.   | 3722  |     |       |              |

ABANDONED

3/4 mile

Date Comm. 7-1-57

drill. 1250 JUL 24 '57

3590

JUL 31 '57

2.0 to 5.7

WGS 1957

No test. Kc only Top picked

(Dea 1st)