

Section 9 Township 31 Range 8 WWell No. # 2 CulverCompany ~~Globe Construction~~ Pickrell Dredg.

NORTH

				0			

SOUTH

Harper

KANSAS

SEC.	TWP.	R.
9	31	8W

WELL NO.

#2 Culver

FARM

COMPANY

~~Pickrell Delg.~~
~~Globe Construction~~

CONTRACTOR

Purcell & Mull
Grabs Pool

Ft. from N. Line

330


Ft. from S. Line

Ft. from E. Line

330

Ft. from W. Line

SW SW SE

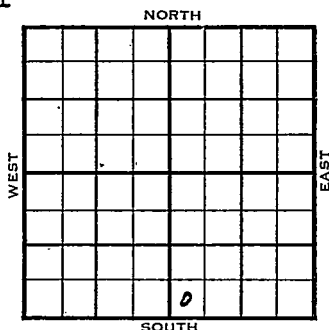

1954

ELEVATION

1615'

REPORT

12/22

Spud 12-20-54

8" @ 150'

WOC.

3/23

Spud 12-20-54, Oil Well, TD 4471
 8" @ 150, Lans 3599, Miss 4385,
 DST 4388-98, open 1 hr gas in
 15 min. Rec 140' O & GCM, 1460#
 DST 4399-4415, open 1 hr. gas
 in 45 min. Rec 180' G&OCM,
 30' oily wtr. 1240# TD 4471
 5" @ 4465, GO to 4420 60/4392-
 4402, sd-oil¹-frac, F/10 BOPH
 4 hr 70% wtr.
 Comp. 21 BOPD 60% wtr.

COMPLETED

FABEN GILSTRAP

SCOUT TICKET

DX-201

Kansas

SEC.

9

TWP.

31

R.

8W

WELL NO.

2 Culver

FARM

COMPANY

Pickrell Drlg.

CONTRACTOR

CORRECTION

SW SW SE

____ FT. FROM N. LINE

330


____ FT. FROM S. LINE

____ FT. FORM E. LINE

330

____ FT. FROM W. LINE

NORTH

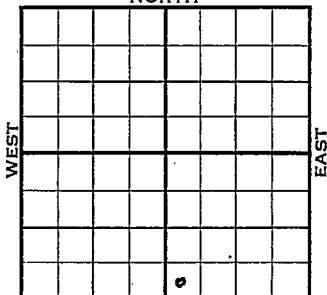

SOUTH

Harper County

☐

LOCATION

☐

RIG UP

DRILLING AND REMARKS:

Reported

Globe Construction

RECORD

PRODUCTION

CASED IN., FT.

SAND

GAS

OIL

TOTAL DEPTH

1ST 24 HRS. NAT.

1ST 24 HRS. AFTER SHOT

GAS CU. FT.

DRY HOLE

ABANDONED

DATE

JAN 1 2 1955

SCOUT

TABEN GILSTRAP

FABEN GILSTRAP