


Section 9 Township 31 Range 8WWell No. 1 DresserCompany Purcell & Mull

NORTH

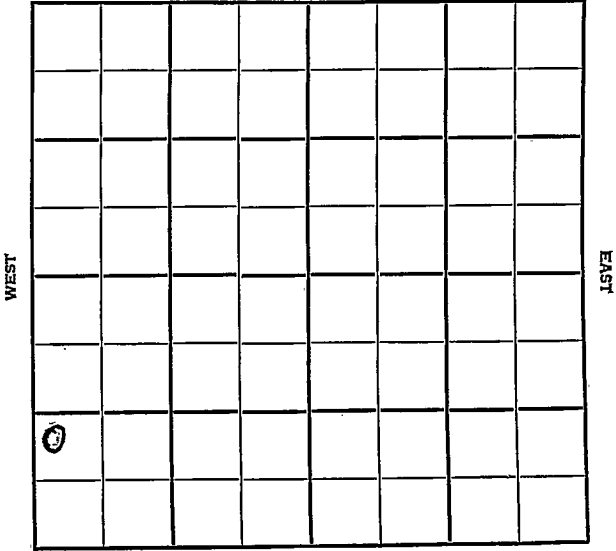

SOUTH

Harper

KANSAS

SEC.	TWP.	R..
9	31	8W

WELL NO.

#1 Dresser

FARM

COMPANY

Purcell & Mull

CONTRACTOR

Co. Tools.

Grabs


Ft. from N. Line

Ft. from S. Line

Ft. from E. Line

Ft. from W. Line

NW SW SW

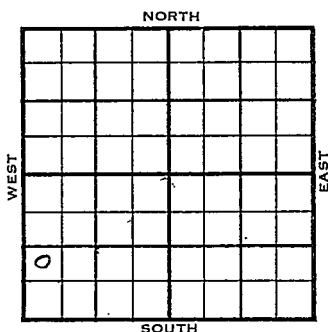

	ELEVATION	REPORT
1955	1647	

7/6 Comm. MIR

9/7 Comm 7-6-55

M 4424

TD 4437

8 5/8" @ 198/150 DST 4427-35 open 2
hr. Rec 40' hocom, 90' muddy oil,
80' clean oil, 10' muddy wtr

980/20" 5 1/2" @ 4437/150 CO to 4436

36/4430-36 500 A S/2 1/2 boph frac

S/135 bo 12 hr S/8 boph P/118 bo 18

hr Comp 121 bopd 5% wtr.

COMPLETED

County Harper Elev. _____
 Sec. 9 Twp. 31 Rge. 8W
 Company Purcell & Mull
 Farm Name Dresser No. 1

Co.

Lse.

No.

Sec.

T.

R.

TOPS	DEPTH	LOG	DATUM
Anh.			
Tp.			
H.			
Tr.			
Dg.			
BL.			
L.			
K.C.			
B.K.C.			
Ce.			
C.			
M.			
M.			
K.			
Mz.			
Mo.			
V.			
S.			
S.			
A.			
R.			
Pe.			
G.			
T.D.			

Loc. in Sec.

NW SW SW

Geol.

Contr.

Co. tools

Pool

Grabs

FIRST REPORT	
JUL 6 '55	
0	

Date Comm.

M T R

County Harper Elev. 1617
 Sec. 9 Twp. 31 Rgs. 8W
 Company Purcell & Mull
 Farm Name Dresser No. 1

Co.

Lse.

No.

Seca

T.

R.

TOPS

DEPTH

LOG

DATUM

Loc. in Sec.

Anh.				NW SW SW
Tr.				
Dg.				
Bl.				
L.				Geol.
K.C.				Contr.
B.K.C.				Co. tools
Ce.				Pool
C.				Grabs
M.	4424		2777	COMPLETE 0
M.				
K.				
Mz.				
Mq.				
V.				
S.				
S.				
A.				
R.				
Pc.				
G.				
T.D.	4437			

Date Comm. 7-6-55 **SEP** 7 1955

8 5/8" @ 198/150 DST 4427-35 open 2 hr

Rec. 40' hocrn 90' muddy oil 80' clean

oil 10' muddy wtr. 980/20" 5 1/2" @

4437/150 CO to 4436 36/ 4430-36

500 A S/ 2 1/2 boph ffrac S/ 135 bo 12 hr.

S/ 8 boph P/ 118 bo 18 hr.

Comp. 121 bopd 5% wtr.