

Section 9 Township 31 Range 8WWell No. 1 WarrenCompany Frank Purcell & J. A. Mull et al

NORTH

				0			

SOUTH

WEST

EAST

SEC.	TWP.	R.
9	31	8W ✓
WELL NO.		
1 Warren		
COMPANY		FARM
Frank Pureell & J. A. Mull et al		
CONTRACTOR		


330 Ft. from N. Line

Ft. from S. Line

Ft. from E. Line

330 Ft. from W. Line

NW NW NE

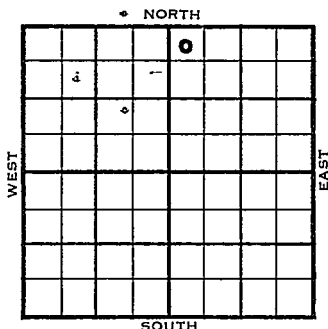

	ELEVATION	REPORT
1954	1650'	
2/10	MIR	
2/17	8" @ 160' w/175 sks Drlg 2857'	
2/24	Drlg 4335'	
3/3	Lans 3650', Miss 4390', Ø 4396'-4416' Ø 4416'-21' DST 4395'-4416' 1 hr, gas 335' OCM, 200' gassy oil, 90' free oil, 630# DST 4416'-21' 1 hr, 40' SW 900# RTD 4422' 5" @ 4421'	
3/10	WOCT.	
3/17	DD 4428' frac. S/ 2½ boph 36 hrs.	
3/24	PB 4416' 24/ 4412-16 frac.	
OVER		

1954
5/5

Spud 2-9-54 Oil well TD 4439
8" @ 160 Lans. 3650 Miss 4390
DST 4395-4416 open 1 hr rec 335'
OCM, 200' gassy oil, 90' free oil
650#
DST 4416-21 open 1 hr rec 40' SW
900# TD 4422 5" @ 4421 DD 4428
frac. S/2 $\frac{1}{2}$ BOPH 36 hr. PB 4416
24/4412-16 frac. DD 4439
sd-frac. S/2 BOPH 12 hr.
Comp. 108 BOPD 15% wtr.


COMPLETED

J. G. McGEHEE

FEB 11 1954

Scout Cards	Go
Land Small Map	
Land Wall Map	
Tracings	
France Map	
Pierce Map	
BB. 1954	

Orig. Data

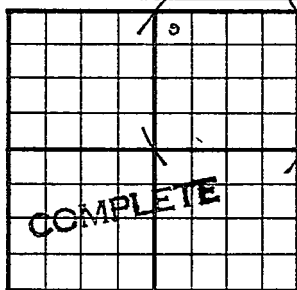County Harper State KansasSec. 9 (Blk.) 31 (Sur.) 8W Map No.Operator Frank Purcell & J. A. Mull etal.Well No. 1 Farm WarrenElev. 1650 Location NW NW NE330 Ft. From N Line NE330 Ft. From W Line Quarter

1st. Report

Completion MAY 5 1954

Remarks

Pickrell Drlg. - Contr.Spudding Date 2-9-54Drlg. Data Oil well TD 44398" @ 160 Lans. 3650 Miss. 4390DST 4395-4416 open 1 hr. Rec. 335' ocm200' gassy oil 90' free oil 650#DST 4416-21 open 1 hr. Rec. 40' sw900# TD 4422 5" @ 4421 DD 4428frac S/ 2 $\frac{1}{2}$ boph 36 hr. PB 441624/ 4412-16 frac DD 4439 sd-fracS/ 2 boph 12 hr. Comp. 108 bopd 15%wtr.

J. G. MCGEHEE

Scout Cards	MM
Land Small Map	
Land Wall M.	5
Tracings	
Frames Map	
Pieces Map	
Misc.	

MAY 10 1934

Orig. Data