
WELL LOG BUREAU—KANSAS GEOLOGICAL SOCIETY
508 East Murdock, Wichita, Kansas

18-32-1W

Company-J. E. MORRIS & FRANCO-CENTRAL OIL CO. SEC. 18 T. 32 R. 1W
Farm-Rother No. 1 NW SW NE

Total Depth. 3821
Comm. 5-30-55 Comp. 6-12-55
Shot or Treated.
Contractor. Rex & Morris Drilling Co.
Issued. 7-16-55

County Sumner
KANSAS

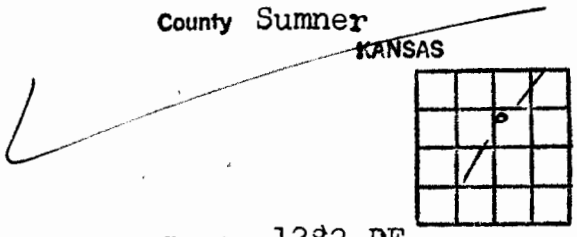

Elevation. 1282 DF

Production. Dry

CASING:
10 3/4 @ 173' w/ 120 sx cmt.

Figures indicate Bottom of Formations

surface hole	178
shale & shells	400
shale & lime	2335
lime	2575
lime & shale	2600
shale & sandy shale	2795
sand	2880
shale & lime	3115
lime	3318
shale & lime	3760
chat & lime	3821
Total Depth	

SCOUT TOPS:

Lansing	2762
Stalnaker	2765
Kansas City	3115
Base KC	3365
Marmaton	3447
Mississippi	3760