

Sec. 8 Twp. 32 R. 1W

Section 8 Township 32 Range 1W

Well No. 1 Etchison

Company Texas

Well No. #1 Etchison Farm

Texas Company


Miscellaneous

_____ Ft. from N. Line

330 Ft. from S. Line

990 Ft. from E. Line

_____ Ft. from W. Line

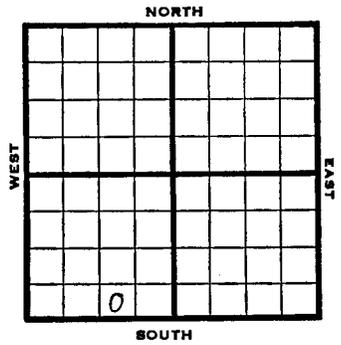


SW SE SW

1946 Elev. 1258 REPORT

- 6/5 Location
- 6/12 RUR
- 6/18 10" @ 238'
Drlg 1717'
- 6/26 Drlg 3145'
- 7/3 KC 3087'
Miss 3718'
Drlg 3762'
- 7/9 Drlg 3976'
- 7/17 Kind 4046
Simp 4116
Arb. 4201
TD 4236'

ABANDONED

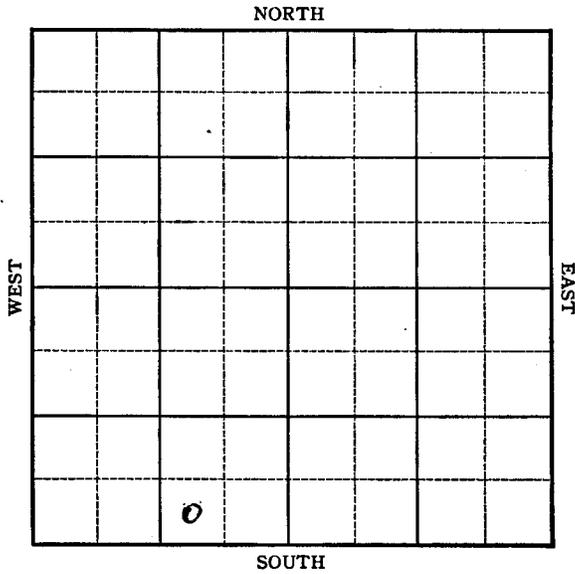

KANSAS

Kansas Pool Name Miscellaneous

Map No. 3 Sec. 8 Twp. 32 R. 1W


Well No. 1 Etchison

Texas Company

FIRST REPORT Contractor

SW SE SW

SECTION PLAT

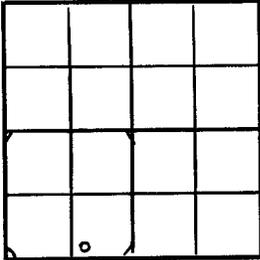

Ft. from N. Line

330 Ft. from S. Line

990 Ft. from E. Line

Ft. from W. Line

Summer County

Location X

Rig up

Drilling and Remarks:

RECORD

Cased _____ in., _____ ft.

Sand _____

Gas _____

Oil _____

Total Depth _____

PRODUCTION

1st 24 hrs. Nat. _____

1st 24 hrs. after shot _____

Gas _____ Cu. Ft.

Dry Hole _____

Abandoned _____

Date

JUN 5 1946 19 S. J. LEWIS Scout

KANSAS

Kansas Pool Name Miscellaneous

Map No. 3 Sec. 8 Twp. 32 R. 1W


Well No. 1 Etchison

Texas Company

ABANDONED Contractor

SW SE SW

SECTION PLAT

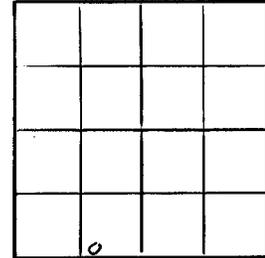

Ft. from N. Line

330 Ft. from S. Line

990 Ft. from E. Line

Ft. from W. Line

Summer County

Location _____

Rig up

Drilling and Remarks:

Kind 4046
Simp 4116
Cost 4201

RECORD

Cased _____ in., _____ ft.

Sand _____

Gas _____

Oil _____

Total Depth 4236

PRODUCTION

1st 24 hrs. Nat. _____

1st 24 hrs. after shot _____

Gas _____ Cu. Ft.

Dry Hole _____

Abandoned _____

Date

JUL 17 1946 19 S. J. LEWIS Scout