
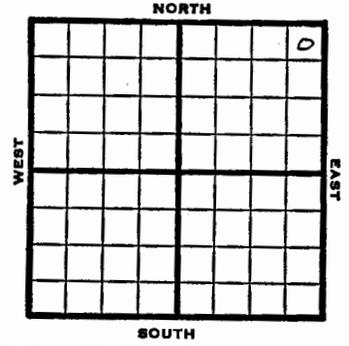


KANSAS Summer

Section 8 Township 32 Range 1-W
 Well No. #1 Vowell
 Company W R Justice

Summer **KANSAS** ✓
 Sec. 8 Twp. 32 R. 1W
 Well No. #1 Vowell Farm _____
W. R. Justice Company _____
 Contractor _____

Wellington Pool
330' Ft. from N. Line
 _____ Ft. from S. Line
330' Ft. from E. Line
 _____ Ft. from W. Line
NE NE NE

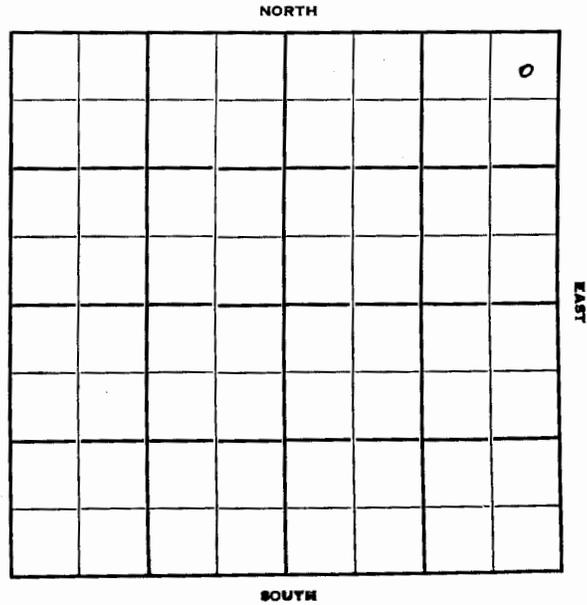

1950	Elev 1201'	REPORT
4/5	Spud 3-31-50 8" @ 91' Drlg. 1040	
4/26	TD 3665' 8" @ 91' Miss 3626' 5 1/2" @ 3630' TD 3665 5000 A Swab 10 boph Comp 50 bopd Comp	
COMPLETED		

Kansas

Wellington Pool

Map No. _____ Sec. 8 Twp. 32 R. 1W

Well No. 1 Vowell

W. R. Justice Company

Contractor

NE NE NE

SECTION PLAT



330 Ft. from N. Line

_____ Ft. from S. Line

330 Ft. from E. Line

_____ Ft. from W. Line

Sumner County

Location _____

Rig up _____

Drilling and Remarks _____

Spud 3-31-50

8" @ 91

drlg. 1040

RECORD

Cased _____ in., _____ ft.

Sand _____

Gas _____

Oil _____

Total Depth _____

PRODUCTION

1st 24 hrs. Nat. _____

1st 24 hrs. after shot _____

Gas _____ Cu. Ft.

Dry Hole _____

Abandoned _____

Date

APR 5 1950 19

J. E. TYRA Scout

Kansas

Wellington Pool

Map No. _____ Sec. 8 Twp. 32 R. 1W


Well No. 1 Vowell

W. R. Justice Company

Contractor

NE NE NE

E. 1201 SECTION PLAT

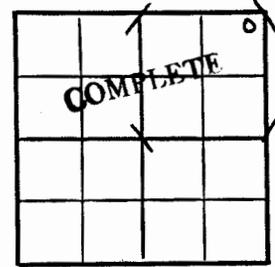

330 Ft. from N. Line

_____ Ft. from S. Line

330 Ft. from E. Line

_____ Ft. from W. Line

Sumner County

Location _____

Rig up _____

Drilling and Remarks:

8" @ 91

Miss. 3626

5 1/2" @ 3630

T.D. 3665

5000 A

Swal 10 bop

Comp 50 bop

APR 26 1950 19

J. E. TYRA Scout

RECORD

Cased _____ in., _____ ft.

Sand _____

Gas _____

Oil _____

Total Depth 3665

PRODUCTION

1st 24 hrs. Nat. _____

1st 24 hrs. after shot _____

Gas _____ Cu. Ft.

Dry Hole _____

Abandoned _____