

Section 7 Township 32 Range 1W

Well No. 1 McDowell "B"

Company C R A

Misc.  
NORTH

					0.		

WEST

EAST

SOUTH

Sec. 7 Twp. 32 R. 1W ✓

Well No. 1 McDowell "B" Farm

C R A Company

Miscellaneous


330 Ft. from N. Line

\_\_\_\_\_ Ft. from S. Line

\_\_\_\_\_ Ft. from E. Line

990 Ft. from W. Line

NE NW SE

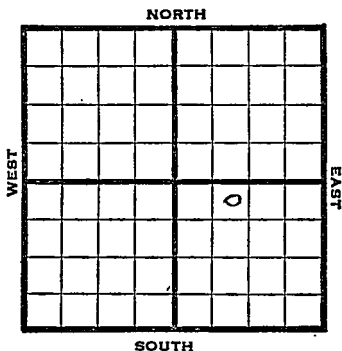

1948 Elev. 1253' REPORT

8/25 Location

9/1 8" @ 141'

9/8 Drlg. 2443'

9/14 KC 3076'  
Miss. 3722'  
Drlg. 3763'

9/22 Miss 3722'  
TD 3780'

**ABANDONED**

Sumner County Kansas State

Map No. \_\_\_\_\_ Sec. 7 Twp. 32 R. 1W

Well No. 1 McDowell "B"

C R A Company

CRSI REPORT Contractor

NE NW SE

SECTION PLAT

330 Ft. from N. Line

\_\_\_\_\_ Ft. from S. Line

\_\_\_\_\_ Ft. from E. Line

990 Ft. from W. Line

					0		

Miscellaneous

Remarks:

Date  
AUG 25 1948

Scout S. J. LEWIS

Sumner County Kansas State

Map No. 31 Sec. 7 Twp. 32 R. 17

Well No. 1 McDowell "B"

C R A Company

**ABANDONED**

Contractor

~~NE~~ NW SE

E 11253

SECTION PLAT

330 Ft. from N. Line

\_\_\_\_\_ Ft. from S. Line

\_\_\_\_\_ Ft. from E. Line

990 Ft. from W. Line

						0	

Miscellaneous

Remarks:

*Mus 2722*  
*752780*

Date  
SEP 22 1948

Scout  
S. J. LEWIS