


Section 9 Township 32 Range 1W

Well No. #1 Stephenson

Company W. R. Justicd

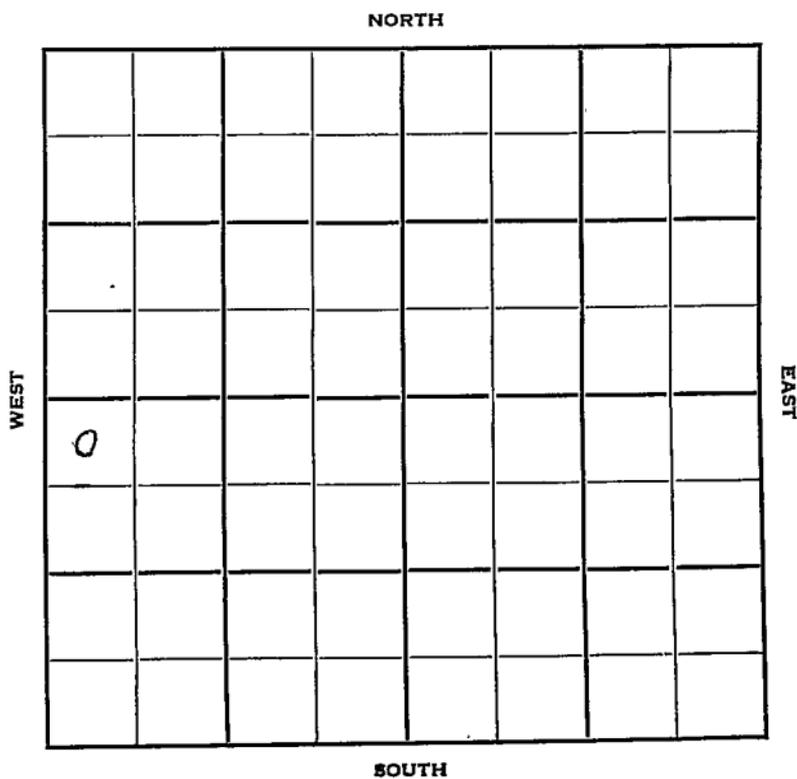

Sec. 9 Twp. 32 R. 1W

Well No. #1 Stephenson Farm

W. R. Justice Company

Laura Jane Contractor


330' Ft. from N. Line

\_\_\_\_\_ Ft. from S. Line

\_\_\_\_\_ Ft. from E. Line

330' Ft. from W. Line

NW NW SW

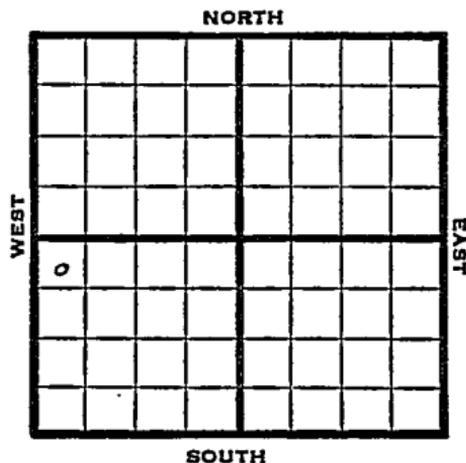

1950

Elev. 1206' REPORT

4/26

8-5/8" @ 120'

5/24

TD 3715  
8 5/8" @ 120  
Miss 3656  
5 1/2" @ 3659  
5000 acid  
SSO  
D&A

**ABANDONED**

Map No. \_\_\_\_\_ Sec. 9 Twp. 32 R. 1W

Well No. 1 Stephenson

W. R. Justice Company

Laura Jane Contractor

NW NW SW


E. 1206  
SECTION PLAT

330 Ft. from N. Line

\_\_\_\_\_ Ft. from S. Line

\_\_\_\_\_ Ft. from E. Line

330 Ft. from W. Line

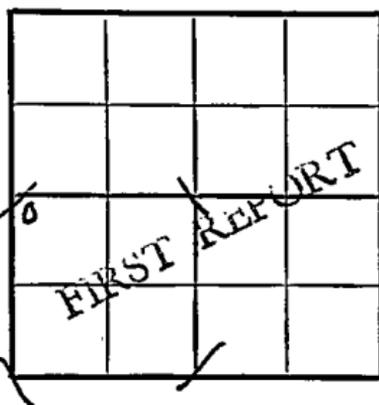

Sumner County

Location \_\_\_\_\_

Rig up \_\_\_\_\_

Drilling and Remarks:

8 5/8" @ 120

## RECORD

Cased \_\_\_\_\_ in., \_\_\_\_\_ ft.

Sand \_\_\_\_\_

Gas \_\_\_\_\_

Oil \_\_\_\_\_

Total Depth \_\_\_\_\_

## PRODUCTION

1st 24 hrs. Nat. \_\_\_\_\_

1st 24 hrs. after shot \_\_\_\_\_

Gas \_\_\_\_\_ Cu. Ft.

Dry Hole \_\_\_\_\_

Abandoned \_\_\_\_\_

Date

APR 26 1950 19

J. E. TYRA Scout

Kansas

Map No. \_\_\_\_\_ Sec. 9 Twp. 32 R. 1W

Well No. L Stephenson

W. R. Justice \_\_\_\_\_ Company


Contractor

NW NW SW

E1.1206  
SECTION PLAT330 Ft. from N. Line

\_\_\_\_\_ Ft. from S. Line

\_\_\_\_\_ Ft. from E. Line

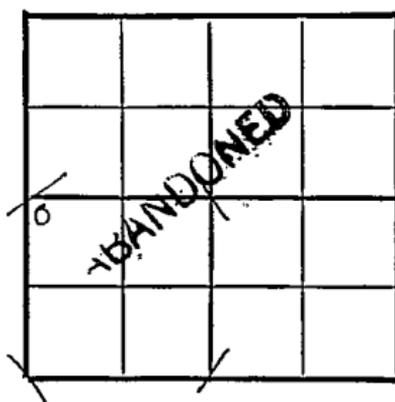330 Ft. from W. Line

Sumner

Location \_\_\_\_\_

Rig up \_\_\_\_\_

Drilling and Remarks:

8 7/8" c 120  
 Miss: 3656  
 5 1/2" c 3659  
 T.D. 3715  
 5000 acid  
 SSO D+A

## RECORD

Cased \_\_\_\_\_ in., \_\_\_\_\_ ft.

Sand \_\_\_\_\_

Gas \_\_\_\_\_

Oil \_\_\_\_\_

Total Depth 3715

## PRODUCTION

1st 24 hrs. Nat. \_\_\_\_\_

1st 24 hrs. after shot \_\_\_\_\_

Gas \_\_\_\_\_ Cu. Ft.

Dry Hole \_\_\_\_\_

Abandoned \_\_\_\_\_

Date

MAY 24 1950 19J. E. TYRA Scout