
FORM 51 25M 3-49 PETROL Sumner KANSAS

Section 18 Township 32 Range 1W

Well No. #1 Almack

Company Flynn Oil

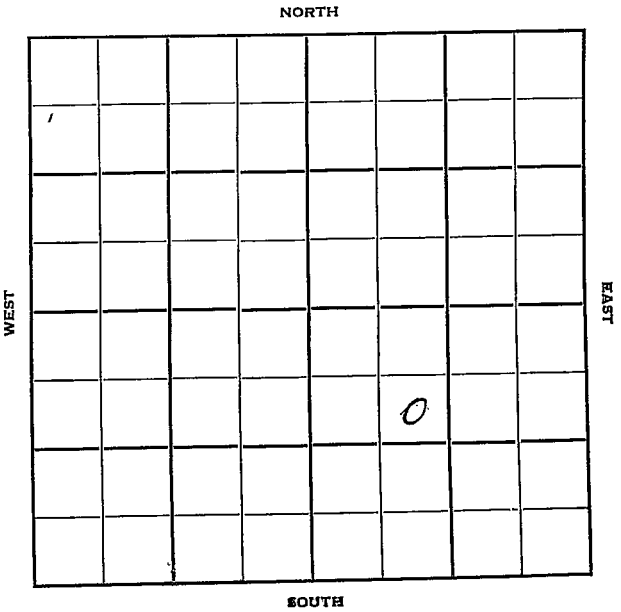

FORM 252-B
10M 11-50 PETROL

Sumner

KANSAS

Sec. 18 Twp. 32 R. 1 W

Well No. # 1 Almack Farm

Flynn Oil Company

Barbour Drlg. Contractor

Wildcat


990 Ft. from N. Line

Ft. from S. Line

Ft. from E. Line

990 Ft. from W. Line

SE NW SE

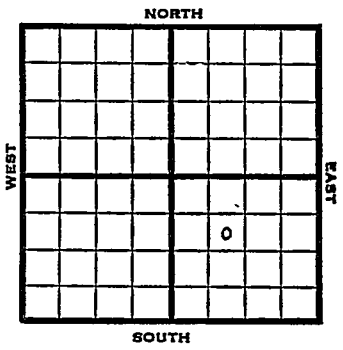

REPORT

1951 Elev. 1276'

10/3 Location

10/24 Spud 10-5-51
D & A TD 3770' 8-5/8" @ 487
KC 3109' Miss 3750'
TD 3770' D & A

ABANDONED

FORM 275 FOR SALE BY KANSAS BLUE PRINT CO.


County Sumner State Kansas

Sec. 18 (Blk. Twp.) 32 (Sur. Rge.) 1W Map No.

Operator Flynn Oil

Well No. 1 Farm Almack

Elev. Location SE NW SE

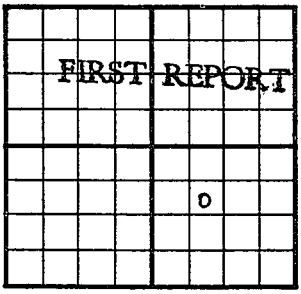

990 Ft. From N Line SE

990 Ft. From W Line Quarter

1st. Report OCT 3 1951

Completion

Remarks

Spudding Date

Drlg. Data Wildcat

Location

J. E. TYRA

FORM 275 FOR SALE BY KANSAS BLUE PRINT CO.


County Sumner State Kansas

Sec. 18 (Blk. Twp.) 32 (Sur. Rge.) 1W Map No.

Operator Flynn Oil

Well No. 1 Farm Almack

Elev. 1276 Location SE NW SE

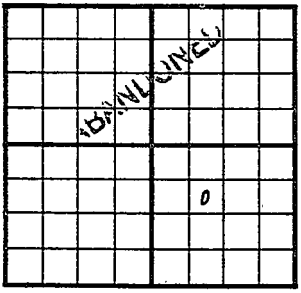

990 Ft. From N Line SE

990 Ft. From W Line Quarter

1st. Report

Completion OCT 24 1951

Remarks Wildcat

Barbour Drlg. - Contr.

Spudding Date 10-5-51

Drlg. Data D & A TD 3770

8 5/8" @ 487 KC 3109 Miss. 3750

TD 3770 D & A

J. E. TYRA