KANSAS


Form 51—5M—4-36—Palace

Sumner

Section 18 Township 32 Range 1-W

Well Number #1 McCowan

Company Pryor & Lockhart

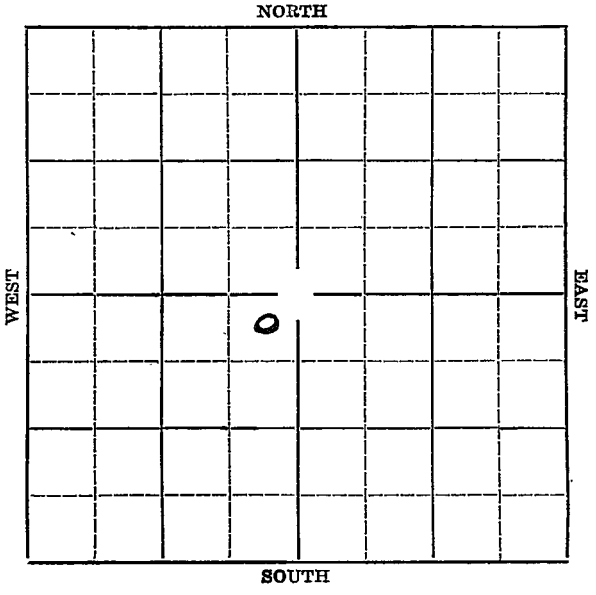

Form 252-A
5M 7-35 MPC

Sumner

Map No. KANSAS Sec. 18 Twp. 32 R. 1W

Well No. #1 McCowan Farm


Pryor & Lockhart Company

330' Ft. from N. Line

Ft. from S. Line

330' Ft. from E. Line

Ft. from W. Line

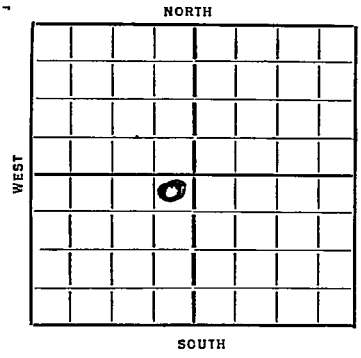

Elev. 1278

Date 1956	REPORT
7/22	Building rig.
7/30--	
8/6	12" @ 415'. Drlg.
8/13	Drlg. 2355'.
8/20	Drlg. 2930'.
8/27	Chat 3738'. 8" @ 3740'. RUST.
9/3	Cleaning out.
9/10	Drlg. 3815'.
9/18	Drlg. 4005'.
9/24	Wilcox 4151'. Drlg. 4152'.
10/1	Base Wilcox 4184'. Drilling.
10/8	Sil. 4241'. T.D. 4276'. ¾Shut down
10/14/36	-Chat 3741'.
	Wilcox 4151'.
	Sil. 4241'.
	T.D. 4277'.
	Dry and abandoned.
	ABANDONED

Form 26—1M Bks.—2-29

Sumner

KANSAS


Map No. 31 Sec. 18 Twp. 32 R. 1W

Well No. 1 McCowan

Pryor & Lockhart Company

Contractor

SECTION PLAT

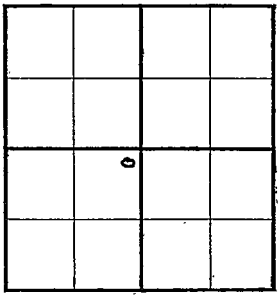

330 Ft. from N. Line

_____ Ft. from S. Line

330 Ft. from E. Line

_____ Ft. from W. Line

FIRST REPORT

Location_____

Rig up_____

Drilling and Remarks:

Building rig

RECORD

Cased_____ in., _____ ft.

Sand_____

Gas_____

Oil_____

Total Depth_____

PRODUCTION

1st 24 hrs. Nat._____

1st 24 hrs. after shot_____

Gas_____ Cu. Ft.

Dry Hole_____

Abandoned_____

Date

JUL 22 1936 19____

S. J. LEWIS Scout

Form 26 1M Blks 2-29

KANSAS


Map No. 31 Sec. 18 Twp. 32 R. 14W

Well No. McCowan

Slick, Payor & Lockhart Company

Contractor

SECTION PLAT

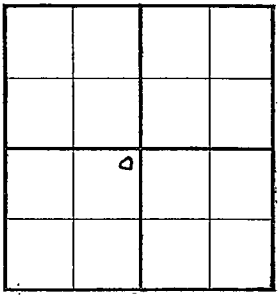

330 Ft. from N. Line

Ft. from S. Line

330 Ft. from E. Line

Ft. from W. Line

ABANDONED

Location

Rig up

Drilling and Remarks:

Chat 3741
Wilcox 4151
Sil 4241

TD 4277

RECORD

Cased in., ft.

Sand

Gas

Oil

Total Depth 4277

PRODUCTION

1st 24 hrs. Nat.

1st 24 hrs. after shot

Gas Cu. Ft.

Dry Hole

Abandoned

Date

OCT 14 1936 19

S. J. LEWIS Scout