


Section 18 Township 32 Range 1-W

Well No. 2 McKowen

Company E. B. Shawver & Pryor & Lockhart

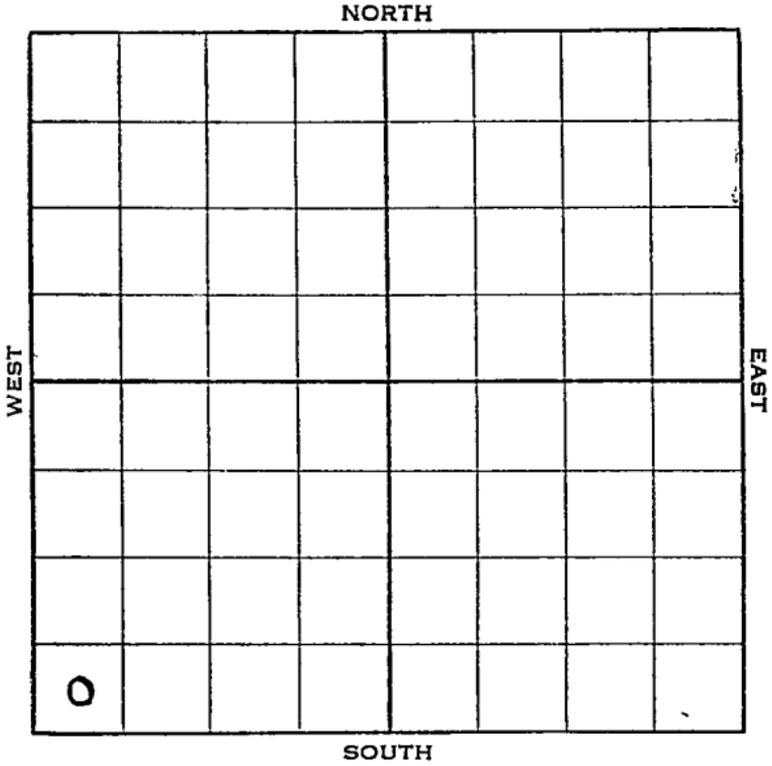

Sec. 18 Twp. 32 R. 1-W

Well No. #2 McKowen Farm

E. B. Shawver, & Pryor & Company


Lockhart NORTH

 Ft. from N. Line

330 Ft. from S. Line

 Ft. from E. Line

330 Ft. from W. Line

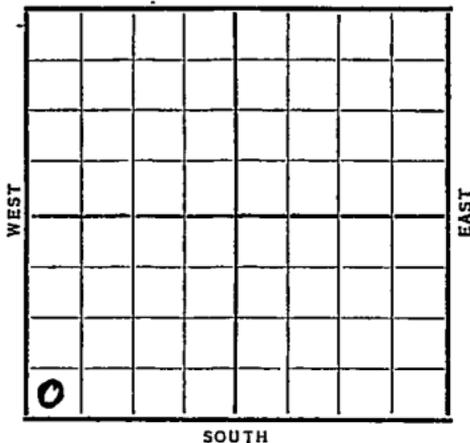

Elev. 1259

Date	REPORT
1938	
3/9	R U R
3/18	S. H.
3/25	12" @ 410'.
	Drlg. 1960'.
4/1	Drlg. 2930'.
4/8	Chat 3728'. 7" @ 3730'.
	No shows. RUST.
4/15	" " "
	" " "
4/20	7" @ 3730'.
	Chat 3728'.
	T.D. 3779'.
	S.S.O. & G. 3740-45'.
	ABANDONED

Map No. 31 Sec. 18 Twp. 32 R. 1WWell No. 2 McKowenE. B. Shawver & Pryor Company
& Lockhart
ContractorABANDONED
SW/C

SECTION PLAT

0			

 Ft. from N. Line330 Ft. from S. Line Ft. from E. Line330 Ft. from W. LineLocation Rig up

Drilling and Remarks:

SSO4G 3740-45DVA

RECORD

Cased 7 in., 3730 ft.Sand Chat 3728Gas Oil Total Depth 3779

PRODUCTION

1st 24 hrs. Nat. 1st 24 hrs. after shot Gas Cu. Ft.Dry Hole Abandoned

Date

APR 20 1938 19H. D. Hatfield Scout