
Sumner

KANSAS

SECTION 18 TOWNSHIP 32 RANGE 1W

WELL NO. #6 O'Hara

COMPANY Stelbar

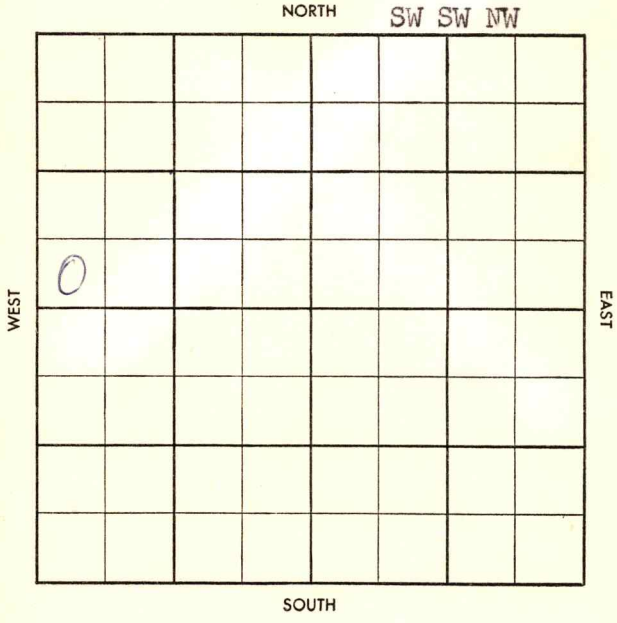

FORM 504-3 SUNRAY

S-513-A

CO. Sumner ELEV. Est. 1270 DF

SEC. 18 TWP. 32 RGE. 1W

COMPANY Stelbar NO. 6

COMPLETE

JAN 29 '58

FARM O'Hara

LOC. SW SW NW

GEOL.

CONTR. Stelbar Tools

POOL Ohara

SPUD 10-27-57 MIRT

8" 410 NOV 6 '57

Log Tops

LSg 2739. 5½ 2750

Icc 3094 RTD 3346

5" 3346

NOV 13 '57

NOV 20 '57 CO 32/3286

TD 3346

-94 acid

$ 6BOPH NW Thru tstg.

NOV 27 '57 2 Flo 70BO NW 1hr

Flo 200 BOP & NW w/o pot

DEC 4 '57 DEC 11 '57 DEC 18 '57 DEC 26 '57

JAN 2 '58 JAN 8 '58 w/o pot JAN 15 '58 JAN 22 '58

JAN 29 '58 Pot P 288 BOP & NW

CO. LSE. NO. SEC. TWP. RGE.

S-513-A

CO. Sumner ELEV.

SEC. 18 TWP. 32 RGE. 1W

COMPANY Stelbar NO. 6

FARM O'Hara

LOC. SW SW NW

GEOL.

CONTR. Stelbar Tools

POOL Ohara

SPUD MIRT

OCT 23 '57

FIRST REPORT

CO. LSE. NO. SEC. TWP. RGE.