DX 78-1


Sumner

KANSAS

Section 18 Township 32 Range 1W

Well No. #1 Rother

Company Franco-Central & Ed Morris

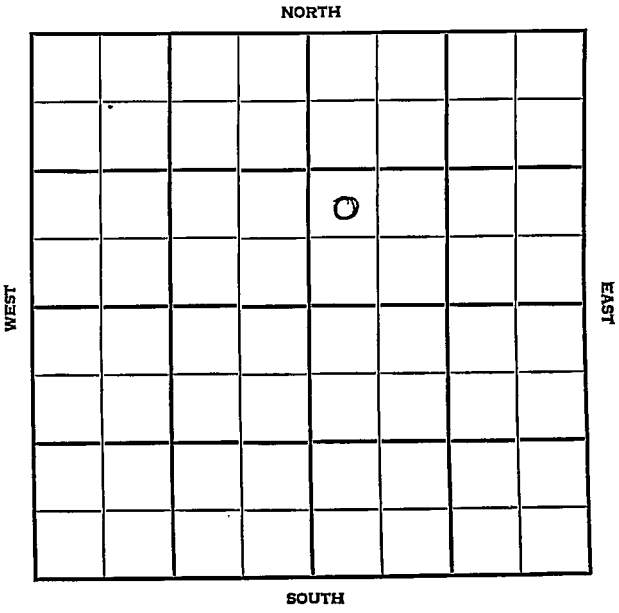

Sumner KANSAS

SEC.	TWP.	R.
18	32	1W

WELL NO.

1 Rother FARM

COMPANY

Franco-Cenrral & Ed Morris

CONTRACTOR

Rex-Morris

O'Hara Pool


~~280~~ Ft. from N. Line

990' Ft. from S. Line

Ft. from E. Line

330' Ft. from W. Line

NW SW NE

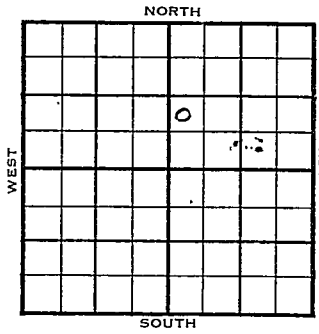

1955	ELEVATION REPORT
6/1	Location
6/15	Comm 5-31-55 10" @ 174/120 DST 3254-71, open 1 hr. Rec. 90' socm 70/20" DST 3301-18, open 1 hr. Rec. 65' mud 45/20" DST 3781-3821 open 1 hr. Rec. 85' mud 1230/20". D&A.

Tops:	Depth	Datum
L	2762	1481
KC	3115	1834
BKC	3365	2084
Ce Stal	2765	1484
C. Marm	3447	2166
M.	3760	2479
TD.	3821	

ABANDONED

DX-78

FORM 275 FOR SALE BY KANSAS BLUE PRINT CO.


County Sumner State Kansas

Sec. 18 (Blk. Twp.) 32 (Sur. Rge.) 1W Map No.

Operator Franco-Central & Ed Morris

Well No. 1 Farm Rother

Elev. Location NW SW NE

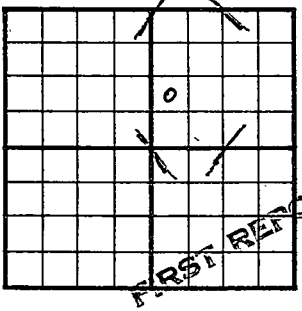

990 Ft. From S Line NE

330 Ft. From W Line Quarter

1st. Report JUN 1 1955

Completion

Remarks

Rex & Morris - Contr.

Spudding Date

Drlg. Data O'Hara Pool

Location

C-32

FORM 513 REV. SUNRAY

County Sumner Elev. 1281

Sec. 18 Twp. 32 Rge. 1W

Company Franco-Central & Ed Morris

Farm Name Rother No. 1


TOPS	DEPTH	LOG	DATUM
Anh.			
Tp.			
H.			
Tr.			
Dg.			
Bl.			
L.	2762		1481
K.C.	3115		1834
B.K.C.	3365		2084
Ce. Stal	2765		1484
C. Marm	3447		2166
M.	3760		2479
M.			
K.			
Mz.			
Mo.			
V.			
S.			
S.			
A			
R.			
Pe.			
G.			
T.D.	3821		

Loc. in Sec. NW SW NE

Geol.

Contr. Rex & Morris

Pool O'Hara

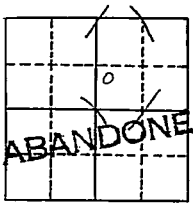

Date Comm. 5-31-55 JUN 15 1955

10" @ 174/120 DST 3254-71 open 1 hr.

Rec. 90' socm 70/20" DST 3301-18

open 1 hr. Rec. 65' mud 45/20"

DST 3781-3821 open 1 hr. Rec. 85' mud

1230/20"

D & A

Co. Lse. No. Sec. T. R.