

O. W. D. D.

Section 10 Township 32 Range 7W

Well No. #1 Worden

Company J. P. Branch & Co
P. C. Robinson (Oxnard, Calif)

NORTH

NW SW NW

WEST

EAST

6							

SOUTH

KANS

Sumner



Sec. 10 Twp. 32 R. 1-W

Well No. #1 Worden Farm

P. C. Robinson Company

Williams Contr Contractor

Wellington


_____ Ft. from N. Line

990 Ft. from S. Line

_____ Ft. from E. Line

330 Ft. from W. Line

NW SW NW .

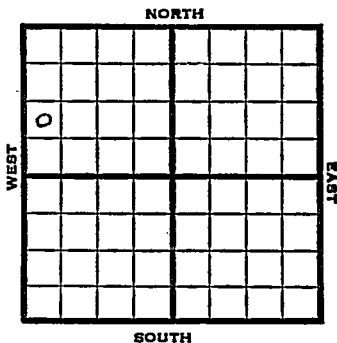

1950	Elev.	REPORT
12/13	Spud 12-11-50 8" @ 115	
1951 1/31	Spud 12/11/50 D & A TD 3720 8" @ 115 Lans. 3020 Miss. 3680 TD 3720 D & A	
	ABANDONED	

~~Telephone Pool~~
~~Gas~~ ~~Water~~ ~~Power~~

O. W. D. D

S-513-B

County Sumner Elev. _____
 Sec. 10 Twp. 32 Rge. 1W
 Company W. P. Branch & Co. (Oxnard, Calif)
 Farm Name Worden No. 1

TOPS	DEPTH	LOG	DATUM
Anh.			
Tp.			
H.			
Tr.			
Dg.			
B.L.			
L.	3020		
K.C.			
B.K.C.			
Ce.			
C.			
M.	3680		
M.			
K.			
Mz.			
Mq.			
V.			
S.			
S.			
A.			
R.			
Pf.			
G.			
T.D.			

Loc. in Sec. _____
 NW SW NW
 OWDD
 Geol. **O. W. D. D**
 Contr. _____
 Sec. ~~Po. Bee~~
 Pool _____
 Wellington

9 MAY 14 1958
FIRST REPORT

Date Comm. _____
OTD 3720 DD 3735 Sch. _____

Co.
Lse.
No.
Sec.
T.
R.

County Sumner State Kansas

Sec. 10 (Blk.) 32 (Sur.) 1W Map No. (Twp.)

Operator P. C. Robinson

Well No. 1 Farm Gorden

Elev. Location NW SW NE

0					
FIRST REPORT					

990 Ft. From S Line NW

330 Ft. From W Line Quarter

1st. Report DEC 13 1950

Completion

Remarks

Williams - Contr.

Spudding Date 12-11-50

Drlg. Data Wellington Pool

8" @ 115

J. E. TYRA


County Sumner State Kansas

Sec. 10 (Blk. Twp.) 32 (Sur. Rge.) 1W Map No.

Operator P. C. Robinson

Well No. 1 Farm Worden

Elev. _____ Location NW SW NW

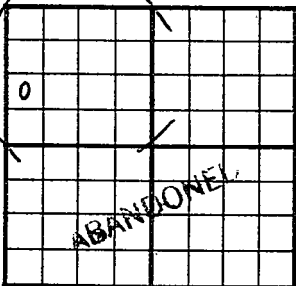

990 Ft. From S Line NW

330 Ft. From W Line Quarter

1st. Report

Completion JAN 31 1951

Remarks Wellington Pool

Williams - Contr.

Spudding Date 12-11-50

Drilg. Data D & A TD 3720

8" @ 115 Lans. 3020 Miss. 3680

TD 3720 D & A

J. E. TYRA

Twp. ~~X~~ Pool ~~X~~

O. W. D. D Co. ~~X~~ Facet ~~X~~

S-513-B

County Sumner Elev. 1215 DF
 Sec. 10 Twp. ~~32~~ Rge. 1W
 Company W. P. Branch & Co. (Oxnard, Calif)
 Farm Name Worden No. 1

TOPS	DEPTH	LOG	DATUM
Anh.			
Tp.			
H.			
Tr.			
Dg.			
B.L.			
L.	3020		
K.C.			
B.K.C.			
Ce.			
C.	3680		
M.			
M.			
K.			
Mz.			
Mq.			
V.			
S.			
S.			
A.			
R.			
Pf.			
G.			
T.D.	3735		

Loc. in Sec. NW SW NW
~~O.W.D.D~~
O. W. D. D
 Geol.

Contr. See-Ro-See
 Pool Wellington

ABANDONED
 MAY 21 '58

Date Comm. OTD 3720 DD 3735 Sch. MAY 21 '58

DDA

Co.
No.
Sec.
T.
R.