
Sumner

KANSAS

SECTION 18 TOWNSHIP 32 RANGE 1W

WELL NO. #4 O'Hara

COMPANY Stelbar Oil

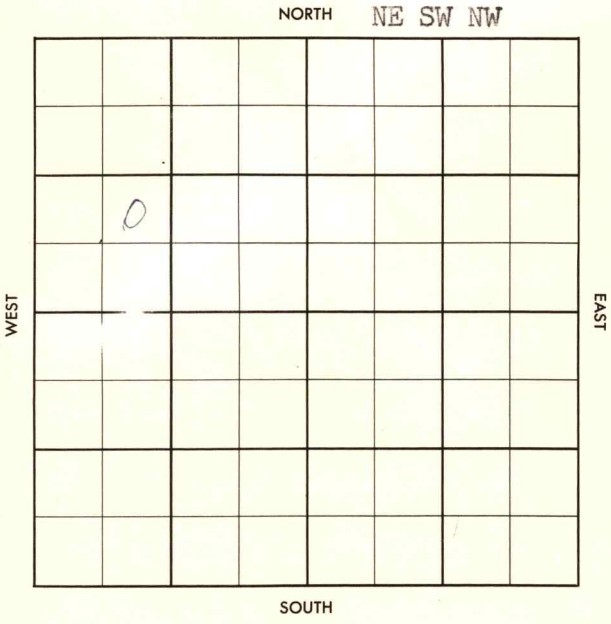

FORM 504-3 SUNRAY

FORM 513 SUNRAY

County Sumner Elev.

Sec. 18 Twp. 32 Rge. 1W

Company Stelbar Oil

Farm Name O'Hara No. 4

TOPS	DEPTH	LOG	DATUM
Anh.			
Tp.			
H.			
Tr.			
Dg.			
Bl.			
L.			
K.C.			
B.K.C.			
Ce.			
C.			
M.			
M.			
K.			
Mz.			
Mo.			
V.			
S.			
S.			
A			
R.			
P€.			
G.			
T.D.			

Loc. in Sec. NE SW NW

Geol.

Contr. Prairie O & G

Pool O'Hara

FIRST REPORT

MAR 29 '57

Date Comm. MIRT

Co. Lse. No. Sec. T. R.

28

FORM 513 SUNRAY

County Sumner Elev. 1280 DF

Sec. 18 Twp. 32 Rge. 1W

Company Stalbar Oil

Farm Name O'Hara No. 4

TOPS	DEPTH	LOG	DATUM
Anh.			
Tp.			
H. Stala	2767		
Tr.			
Dg.			
BL.			
L.			
K.C.	3099		
B.K.C.	3360		
Ce.			
C.			
M.	3736		
M.			
K.			
Mz.			
Mo.			
V.			
S.			
S.			
A			
R.			
PE.			
G.			
T.D.	3782		

Loc. in Sec. NE SW NW

Geol.

Contr. Prairie O &

Pool O'Hara

COMPLETE

JUL 3 '57

Date Comm. MIPT MAR 27 '57 3-22-57 8 5/8

423/310 @ 2150 APR 3 '57

DST 2767-72 op 1 hr. 6/45" rec 360' oil + 530' gssy wtr BHP 740/30" DST 3112-25 op 1 hr rec 40' SOCM + 35' HOCM BHP 298/20" DST 3146-63 op 1 hr rec 110' OCGCM + 40' SW FP 50-95 BHP

FORM 513-1 SUNRAY

1170/30" DST 3253-66
opn 75", G/20" rec 60' Md
+135' 0 Ş GCM +120' VHO Ş
GCM DHP 760/30" crg @
3746 APR 10 '57 crd 3743-50 Foll
rec. DST 3756-82 30"
G/58" rec 55 0 Ş GCM +69'
30 Ş GCM +60' HO Ş GCM
BHP 1485/30" 5½ @ 3762
APR 17 '57 CO 3782 Frac +stg.
APR 24 '57 S.I. MAY 1 '57 MAY 8 '57 est 9a
6 To 8 Mill CFGpd
declined to practically 0
Flow 45 Bo +600 Bw in
18 hrs FP 270# Flw
28 Bo +450 Bw in 28 hrs
PB 3325 48/3293-3305
FU 175' oil in 12 hrs ½
Flwd 160 Bo no/w 6 hrs
MAY 15 '57 P. 101 Bo no/w 24 hrs
MAY 22 '57 MAY 29 '57 JUN 5 '57 JUN 12 '57 JUN 19 '57 JUN 26 '57
JUL 3 '57 JUL 10 '57 JUL 17 '57 JUL 24 '57 JUL 31 '57
Pb P. 91 Bopd no/wtr.
grav 39°

18-32-1W NE SW NW