


Sumner

KAN/CAS

SECTION 18 TOWNSHIP 32 RANGE 1W

WELL NO. #5 O'Hara

COMPANY Stelbar Oil Corp.

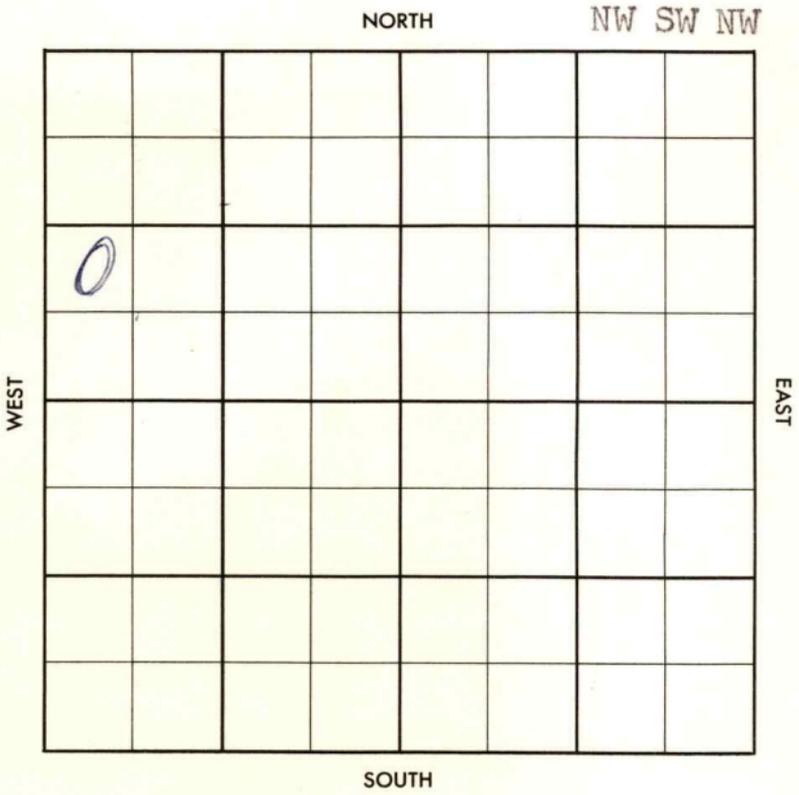

County Sumner Elev. 1270
 Sec. 18 Twp. 32 Rgs. 1W
 Company Stelbar Oil Corp.
 Farm Name O'Hara No. 5

TOPS	DEPTH	LOG	DATUM
Anh. <u>stain</u>		<u>2748</u>	
Tr.			
H.			
Tr.			
Dg.			
Bl.			
L.			
K.C.	<u>3095</u>	<u>3095</u>	
B.K.C.		<u>3353</u>	
Ce.			
C.			
M. <u>chert</u>	<u>3736</u>	<u>3730</u>	
M. <u>L1</u>		<u>3740</u>	
K.			
Mz.			
Me.			
V.			
S.			
S.			
A.			
R.			
Pe.			
G.			
T.D.	<u>3766</u>		

Loc. in Sec. NW SW NW
 Geol. _____
 Contr. Prairie Drl
 Pool _____
 O'Hara
COMPLETE
 AUG 28 '57

Date Comm. M I R T JUN 19 '57 G-15-57 8 5/8
4 1/2 / 250 @ 800 JUN 26 '57 Rn9
5 1/2 JUL 3 '57 5 1/2 @ 3759 Wolt
JUL 10 '57 JUL 17 '57 MICT CO 3766 \$
20 GW in 12 hrs + 56 to Flow
JUL 24 '57 PB 3335 64/3284-3300
FU 1800 oil 12 hrs 12 Flow
20 Boph no/w Flow 80 Bo no/w
8 hrs Pop. JUL 31 '57 AUG 9 '57 AUG 14 '57
AUG 28 '57 P. 29 Bopd + 6290 wts

Co. _____
 Sec. _____
 T. _____
 R. _____

