

Sec. 4 Twp. 32 R. 1W ✓

Well No. #5 DeTurk Farm _____

C R A

Company _____

Miscellaneous (C R A, Cont.)

_____ Ft. from N. Line

330'


_____ Ft. from S. Line

330'

_____ Ft. from E. Line

_____ Ft. from W. Line

SE SW

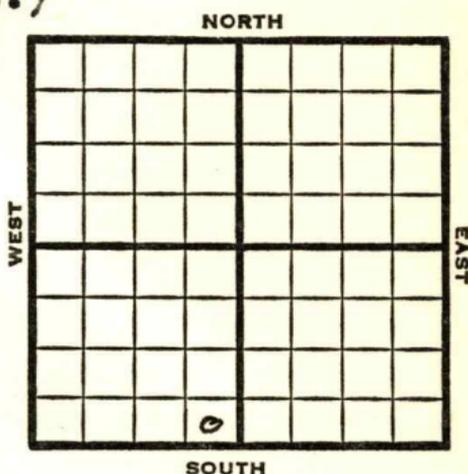

1949

Elev. 1222' REPORT

6/29

10" @ 157'

Drlg. 200'

7/6

Drlg 3140'

7/12

Miss 3642'

TD 3649'

5" @ 3643'

7/20

TD 3665 W

Drlg 3195'

7/27

Miss 3642'

TD 3667'

ABANDONED

Map No. _____ Sec. 4 Twp. 32 R. 1W

Well No. 5 DeTurk

C R A

Company

C R A

Contractor

SE SW

FIRST REPORT
SECTION FLAT

_____ Ft. from N. Line

330 Ft. from S. Line

330 Ft. from E. Line

_____ Ft. from W. Line

Sumner County

Location _____

Rig up _____

Drilling and Remarks:

10" @ 157

drlg. 200

RECORD

Cased _____ in., _____ ft.

Sand _____

Gas _____

Oil _____

Total Depth _____

PRODUCTION

1st 24 hrs. Nat. _____

1st 24 hrs. after shot _____

Gas _____ Cu. Ft.

Dry Hole _____

Abandoned _____

Date

JUN 29 1949 19

S. J. LEWIS

Scout

Kansas Miscellaneous

Map No. K31 Sec. 4 Twp. 32 R. 1W

Well No. 5 De Turk

C R A

Company

~~ABANDONED~~

Contractor

SE SW

E 11222
SECTION PLAT

 Ft. from N. Line

330 Ft. from S. Line

330 Ft. from E. Line

 Ft. from W. Line

Summer County

Location

Rig up

Drilling and Remarks:

Misc 3642

RECORD

Cased in., ft.

Sand

Gas

Oil

Total Depth 3667

PRODUCTION

1st 24 hrs. Nat.

1st 24 hrs. after shot

Gas Cu. Ft.

Dry Hole

Abandoned

Date

JUL 27 1949 19

S. J. LEWIS

Scout