


Section 4 Township 32 Range 1-W

Well No. #1 DeTurk "B"

Company Laura Jane Oil

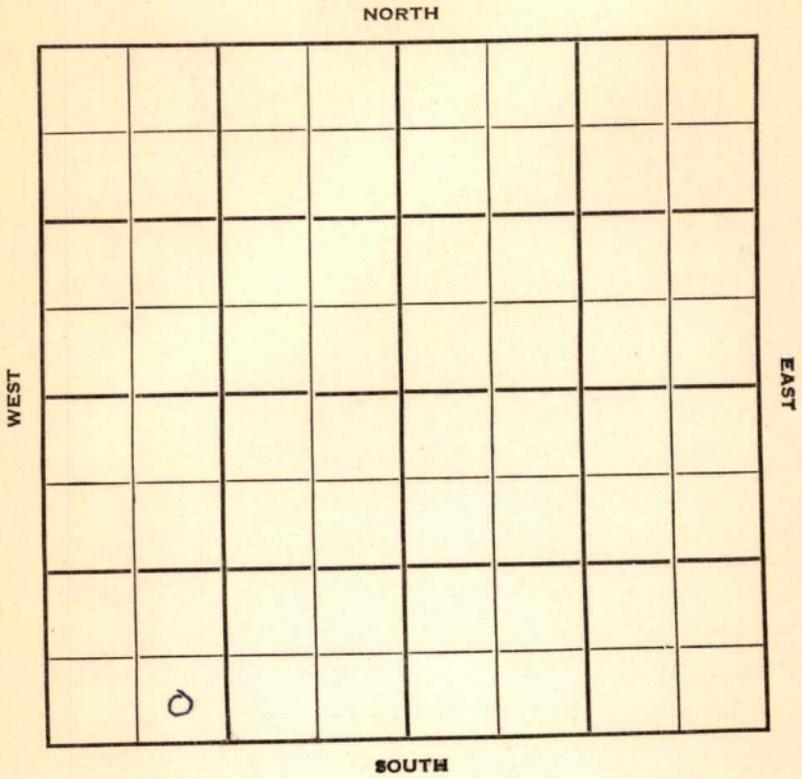

Sec. 4 Twp. 32 R. 1-W ✓

Well No. #1 DeTurk "B" Farm

Laura Jane Oil Company

Contractor


Wellington

\_\_\_\_\_ Ft. from N. Line

330 Ft. from S. Line

\_\_\_\_\_ Ft. from E. Line

990 Ft. from W. Line

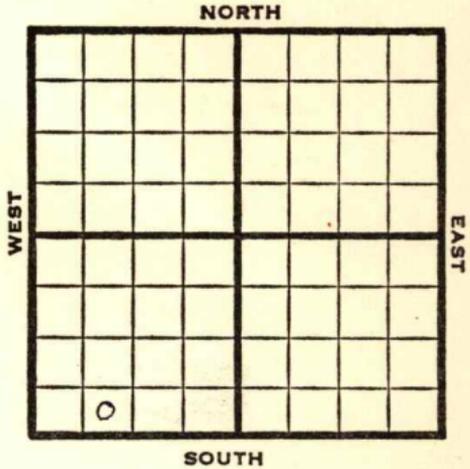

SE SW SW  
CRA farmout

1950 **Elev. 1217'** REPORT

7/19 8" @ 110  
WOC

9/13 OilWell TD 3670'  
8" @110'  
**Miss 3633-35'**  
5" @ 3635'  
**SO 3656-67'**  
TD 3670'  
2000 A  
S/140 B0 12 hr.  
F/6 BOPH  
Comp. 75 BOPD

**COMPLETED**

Kansas

Map No. \_\_\_\_\_ Sec. 4 Twp. 32 R. 1W

Well No. 1 DeTurk "B"

Laura Jane Oil Company

Contractor \_\_\_\_\_

SE SW SW

SECTION PLAT

\_\_\_\_\_ Ft. from N. Line

330 Ft. from S. Line

\_\_\_\_\_ Ft. from E. Line

990 Ft. from W. Line



Sumner County

CRA farmout

Location \_\_\_\_\_

Rig up \_\_\_\_\_

Drilling and Remarks:

8" @ 110

WOC

RECORD

Cased \_\_\_\_\_ in., \_\_\_\_\_ ft.

Sand \_\_\_\_\_

Gas \_\_\_\_\_

Oil \_\_\_\_\_

Total Depth \_\_\_\_\_

PRODUCTION

1st 24 hrs. Nat. \_\_\_\_\_

1st 24 hrs. after shot \_\_\_\_\_

Gas \_\_\_\_\_ Cu. Ft.

Dry Hole \_\_\_\_\_

Abandoned \_\_\_\_\_

Date

JUL 1 9 1950

19

J. E. TYRA

Scout

