

Sumner

KANSAS

Sec. 32 ⁴ Twp. 32 ³¹ R. 1 W

Well No. #2 DeTurk "B" Farm

Laura Jane Oil Company

Laura Jane - Contr. Contractor

Wellington Pool


_____ Ft. from N. Line

990' Ft. from S. Line

_____ Ft. from E. Line

330' Ft. from W. Line

NW SW SW

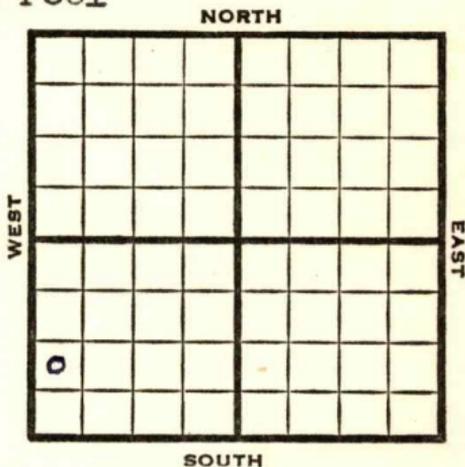

1951

Elev. 1224' REPORT

1/24

Cellar & Pits

2/28

Spud 1-24-51
 Oil Well TD 3680
 8" @ 116 **Miss 3647**
 5" @ 3658 TD 3680
 FU 450' oil 4000 A
 Comp. 25 bopd

COMPLETED

Kansas

Map No. _____ Sec. 4 Twp. 32 R. 1W

Well No. 2 DeTurk "B"

Laura Jane Oil Company

CORRECTION Contractor

NW SW SW

SECTION PLAT

_____ Ft. from N. Line

990 Ft. from S. Line

_____ Ft. from E. Line

330 Ft. from W. Line

Summer County

Location _____

Rig up _____

Drilling and Remarks:

Reported

32-31-1W

RECORD

Cased _____ in., _____ ft.

Sand _____

Gas _____

Oil _____

Total Depth _____

PRODUCTION

1st 24 hrs. Nat. _____

1st 24 hrs. after shot _____

Gas _____ Cu. Ft.

Dry Hole _____

Abandoned _____

Date

JAN 31 1951

19

J. E. TYRA

Scout

