


Section 4 Township 32 Range 1-W

Well Number 1 - DeTurk

Company Sinclair-Prairie

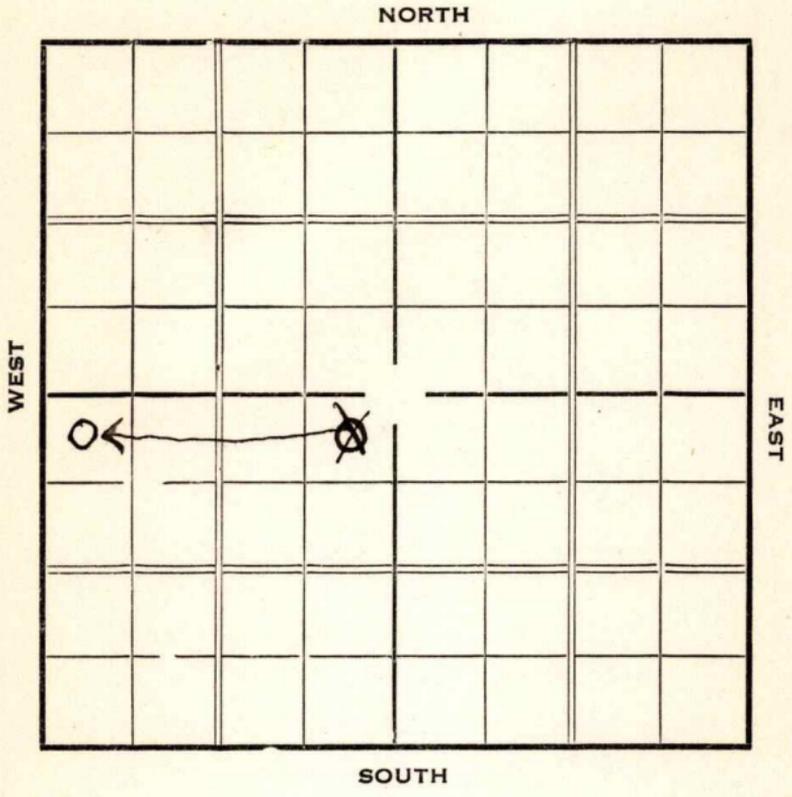



1937

6/28---7" @ 3649'.

Chat 3645'.

T.D. 3679'.

3000 acid. (Total)

Pot. 242 bbls.

**COMPLETED**

*Summer* **KANSAS**

Map No. 31 Sec. 4 Twp. 32 R. 1<sup>w</sup>

Well No. 1 - De Turk

Sinclair Prairie Company

Contractor

### FIRST REPORT

### SECTION PLAT

330 Ft. from N. Line

\_\_\_\_\_ Ft. from S. Line

330 Ft. from E. Line

\_\_\_\_\_ Ft. from W. Line

	0		

Location ✓

Rig up \_\_\_\_\_

Drilling and Remarks:

### RECORD

Cased \_\_\_\_\_ in., \_\_\_\_\_ ft.

Sand \_\_\_\_\_

Gas \_\_\_\_\_

Oil \_\_\_\_\_

Total Depth \_\_\_\_\_

### PRODUCTION

1st 24 hrs. Nat. \_\_\_\_\_

1st 24 hrs. after shot \_\_\_\_\_

Gas \_\_\_\_\_ Cu. Ft.

Dry Hole \_\_\_\_\_

Abandoned \_\_\_\_\_

Date

**APR 28 1937**

19

*H. D. Hatfield* Scout

KANSAS

Summer

Map No. 31 Sec. 4 Twp. 32 R. 1 W

Well No. 1-De Turk

Sinclair Prairie Company

Contractor

COMPLETED

SECTION PLAT

0			

330 Ft. from N. Line

\_\_\_\_\_ Ft. from S. Line

\_\_\_\_\_ Ft. from E. Line

330 Ft. from W. Line

Location \_\_\_\_\_

Rig up \_\_\_\_\_

Drilling and Remarks:

3000 Acid (Total)

Pot - 242

RECORD

Cased 7 in., 3649 ft.

Sand Chat 3645

Gas \_\_\_\_\_

Oil \_\_\_\_\_

Total Depth 3679

PRODUCTION

1st 24 hrs. Nat. \_\_\_\_\_

1st 24 hrs. after shot \_\_\_\_\_

Gas \_\_\_\_\_ Cu. Ft.

Dry Hole \_\_\_\_\_

Abandoned \_\_\_\_\_

Date

JUL 28 1937<sub>19</sub>

H. D. Hatfield Scout

First shows NE SW

First report shows this well in NE SW

Check and advise

Sam

*[Handwritten signature]*  
*[Handwritten signature]*

Returned	<i>[Signature]</i>
Cards	<i>[Signature]</i>
Tracing	<i>[Signature]</i>
France Map	<i>[Signature]</i>
Scarborough Map	<i>[Signature]</i>
Moody Map	<i>[Signature]</i>
Scarborough Plat Book	<i>[Signature]</i>
Moody Plat Book	<i>[Signature]</i>

*Summer* **KANSAS**

Map No. \_\_\_\_\_ Sec. 4 Twp. 32 R. 1 W

Well No. 1 - De Turk

Simclair Prairie Company

Contractor \_\_\_\_\_

**CORRECTION**

330 Ft. from N. Line

\_\_\_\_\_ Ft. from S. Line

\_\_\_\_\_ Ft. from E. Line

330 Ft. from W. Line

**FIRST REPORT**

**SECTION PLAT**

0			

Location \_\_\_\_\_

Rig up \_\_\_\_\_

Drilling and Remarks:

*Incorrectly reported as located in NESW*

**RECORD**

Cased \_\_\_\_\_ in., \_\_\_\_\_ ft.

Sand \_\_\_\_\_

Gas \_\_\_\_\_

Oil \_\_\_\_\_

Total Depth \_\_\_\_\_

**PRODUCTION**

1st 24 hrs. Nat. \_\_\_\_\_

1st 24 hrs. after shot \_\_\_\_\_

Gas \_\_\_\_\_ Cu. Ft.

Dry Hole \_\_\_\_\_

Abandoned \_\_\_\_\_

Date

AUG 3 - 1937

19

H. D. Hatfield

Scout