


Section 4 Township 32 Range 1W

Well Number #3 ~~#~~ Rothrock


Company Stelbar et al

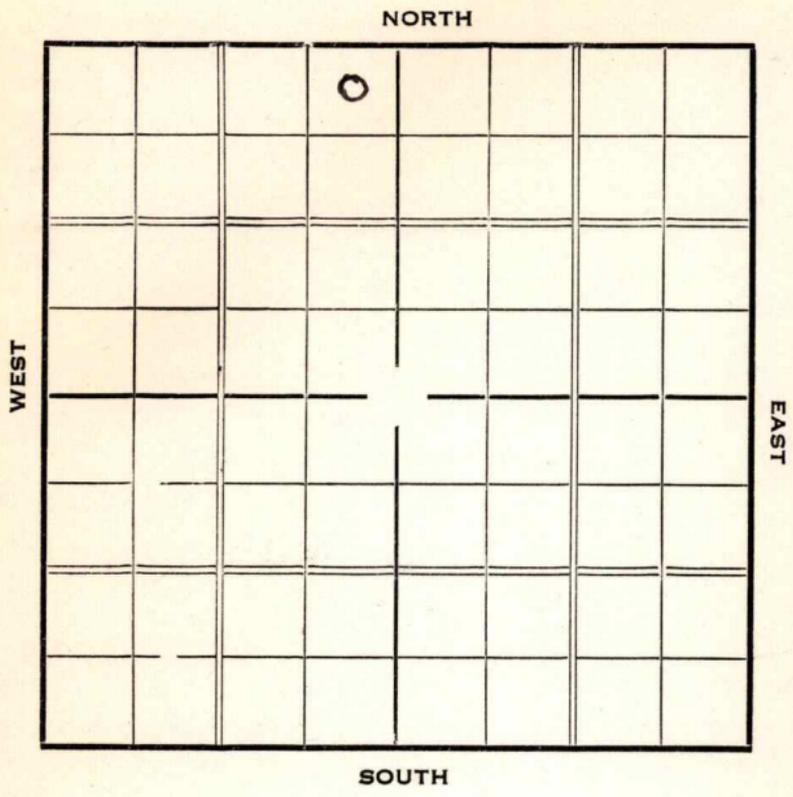

Sec. 4 Twp. 32 R. 1-W

Well No. ~~#~~ [#] 3 **Rothrock** Farm
Stelbar et al Company

330 Ft. from N. Line
 _____ Ft. from S. Line
330 Ft. from E. Line
 _____ Ft. from W. Line

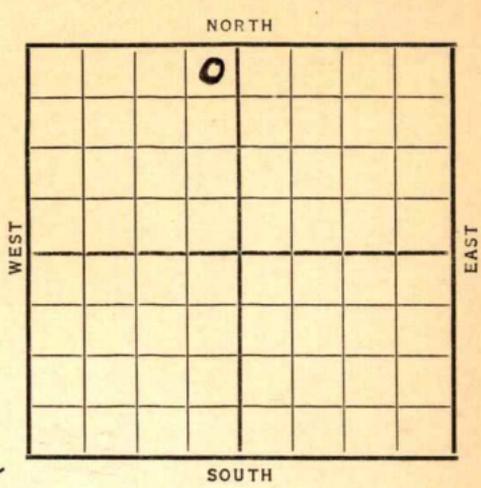

Elev. 1245

Date	REPORT
1937	
1/20	Location
1/28	Cellar
2/4	"
2/11	"
2/18	"
2/26	R O G
3/4	Surface hole.
3/11	10" @ 310' Drlg. 2440'.
3/18	KCL 3020' Drlg. 3401'.
3/25	Chat 3644' set 7". WOC.
4/2	Drlg. 3661'.
4/8	TD 3697', 4000 acid.No test.
4/14	Chat 3646' .
	T.D. 3649'.
	Potential 1040'.
	COMPLETED

Map No. 31 Sec. 4 Twp. 32 R. 1W

Well No. 2 Rothrock

Stelbar & Co Company

Contractor

SECTION PLAT

	0		

330 Ft. from N. Line

_____ Ft. from S. Line

330 Ft. from E. Line

_____ Ft. from W. Line

FIRST REPORT

Location ✓

Rig up _____

Drilling and Remarks:

RECORD

Cased _____ in., _____ ft.

Sand _____

Gas _____

Oil _____

Total Depth _____

PRODUCTION

1st 24 hrs. Nat. _____

1st 24 hrs. after shot _____

Gas _____ Cu. Ft.

Dry Hole _____

Abandoned _____

Date

JAN 20 1937 19

S. J. LEWIS

Scout

Map No. 31 Sec. 4 Twp. 32 R. 1W

Well No. 3 Rotherick

Stellar Company

Contractor

SECTION PLAT

330 Ft. from N. Line

_____ Ft. from S. Line

330 Ft. from E. Line

_____ Ft. from W. Line

CORRECTION

RECORD

Location _____

Rig up _____

Drilling and Remarks:

*Reperced as
No 2*

Cased _____ in., _____ ft.

Sand _____

Gas _____

Oil _____

Total Depth _____

PRODUCTION

1st 24 hrs. Nat. _____

1st 24 hrs. after shot _____

Gas _____ Cu. Ft.

Dry Hole _____

Abandoned _____

Date

JAN 27 1937

19

S. J. LEWIS Scout

KANSAS *Summer*

Map No. _____ Sec. 4 Twp. 32 R. 1W

Well No. 3 Rothrock

Stellar et al Company

Contractor

SECTION PLAT

		0		

330 Ft. from N. Line

_____ Ft. from S. Line

330 Ft. from E. Line

_____ Ft. from W. Line

COMPLETED

Location _____

Rig up _____

Drilling and Remarks:

Cha 3646.

Potential

1040

RECORD

Cased _____ in., _____ ft.

Sand _____

Gas _____

Oil _____

Total Depth 3649

PRODUCTION

1st 24 hrs. Nat. _____

1st 24 hrs. after shot _____

Gas _____ Cu. Ft.

Dry Hole _____

Abandoned _____

Date

APR 14 1937 19

S. J. LEWIS Scout