


Summer

KANSAS

Section 4 Township 32 Range 1-W

Well Number 1 Rothrock

Company Stelbar Oil

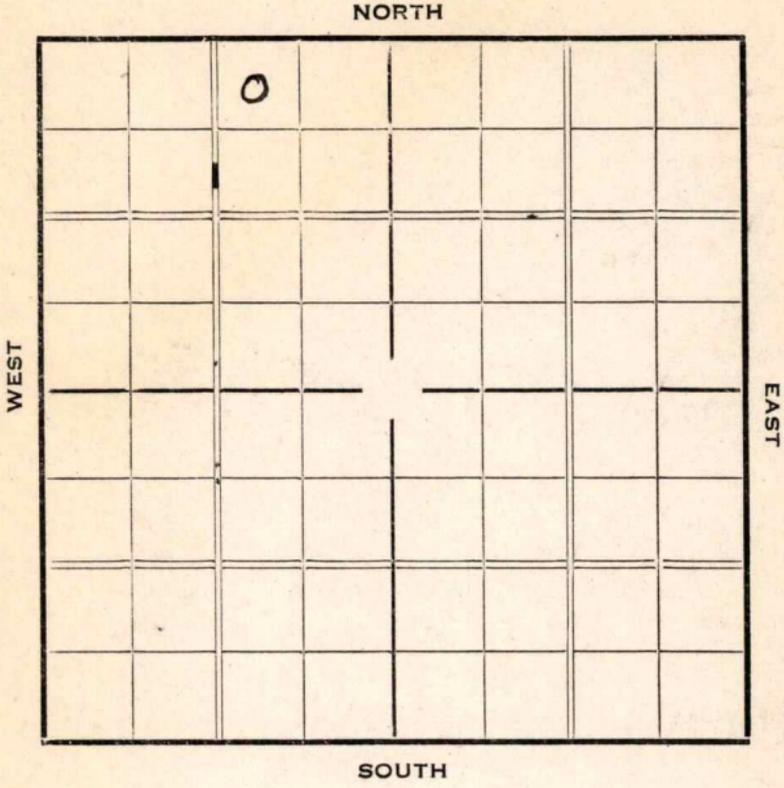

Sec. 4 Twp. 32 R. 1-W

Well No. #1 Rothrock Farm

Stelbar Oil Company


330 Ft. from N. Line

_____ Ft. from S. Line

990 Ft. from E. Line

_____ Ft. from W. Line

Elev. 1246

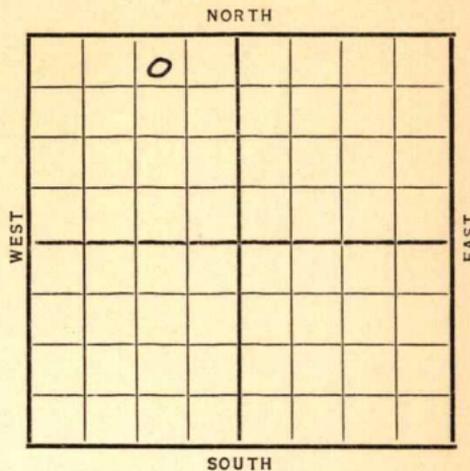

Date	REPORT
11/25	Location
12/3	Rigging up
12/10	12" @ 331'. WOC,
12/17	Drlg. 2350'.
12/24	Drlg. 3310'.
12/29	Chat 3636'. 7" @ 3636' RUST.
1937	
1/7	T. D. 3699'. 1000 acid.
1/13	Chat 3636'. T. D. 3699'.
	1000 acid.
	3000 acid.
	Pot. 1297'.
	COMPLETED

Map No. 31 Sec. 4 Twp. 32 R. 14

Well No. 1 Rotherock

Stellar Oil Company

Contractor

SECTION PLAT

	0		

330 Ft. from N. Line

_____ Ft. from S. Line

990 Ft. from E. Line

_____ Ft. from W. Line

FIRST REPORT

Location ✓

Rig up _____

Drilling and Remarks:

RECORD

Cased _____ in., _____ ft.

Sand _____

Gas _____

Oil _____

Total Depth _____

PRODUCTION

1st 24 hrs. Nat. _____

1st 24 hrs. after shot _____

Gas _____ Cu. Ft.

Dry Hole _____

Abandoned _____

Date

NOV 25 1938

19

S. J. LEWIS

Scout

Map No. 31 Sec. 4 Twp. 32 R. 1W

Well No. 1 Rothrock

Stetson Oil Company

Contractor

SECTION PLAT

330 Ft. from N. Line

_____ Ft. from S. Line

990 Ft. from E. Line

_____ Ft. from W. Line

	0		

COMPLETED

Location _____

Rig up _____

Drilling and Remarks:

Chat 3636
1000 acid
8000 acid
Pat 1297

RECORD

Cased _____ in., _____ ft.

Sand _____

Gas _____

Oil _____

Total Depth 2699

PRODUCTION

1st 24 hrs. Nat. _____

1st 24 hrs. after shot _____

Gas _____ Cu. Ft.

Dry Hole _____

Abandoned _____

Date

JAN 13 1937 19

S. J. LEWIS

Scout