


Section 4 Township 32 Range 1-W

Well Number 4 - Rothrock

Company Stelbar

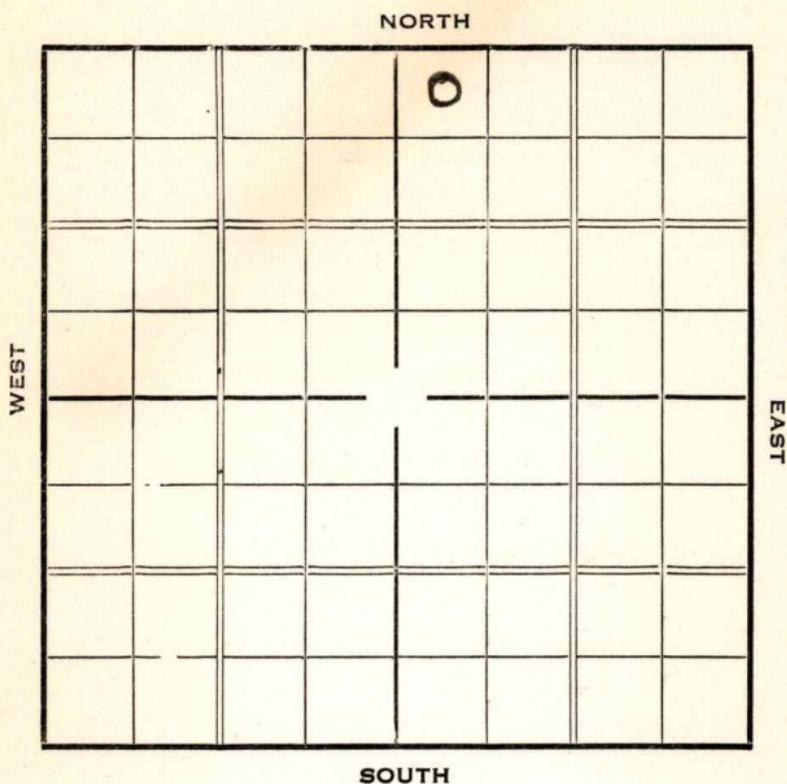

Sec. 4 Twp. 32 R. 1-W

Well No. #4 Rothrock Farm  
Stelbar Company


330 Ft. from N. Line

\_\_\_\_\_ Ft. from S. Line

\_\_\_\_\_ Ft. from E. Line

330 Ft. from W. Line

**Elev. 1254**

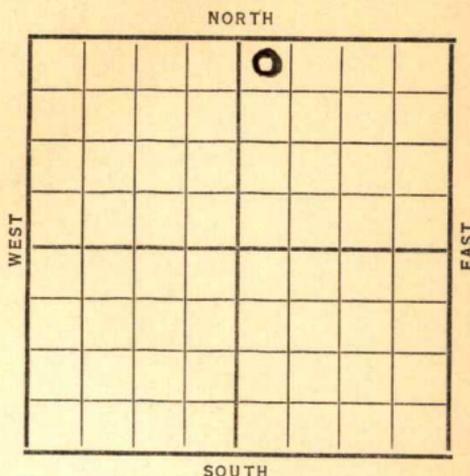

Date	REPORT
1937	
5/12	B. R. R.
5/21	10" @ 336'. Drlg. 1395'.
5/28	Drlg. 3146'.
6/4	<b>Chat &amp; 7" @ 3650'.</b>
	RUST.
6/11	At 3674' flowed 651 bbls. in
	21 hrs. Nat. Drlg. 3688'.
6/16	7" @ 3650'.
	<b>Chat 3650'.</b>
	T.D. 3691'.
	3000 acid.
	Flowed Pot. 1565 bbls.
	<b>COMPLETED</b>

Map No. 31 Sec. 4 Twp. 32 R. 1 W

Well No. 4-Rothrock

Stelbar Company

Contractor

**FIRST REPORT**

**SECTION PLAT**

		0	

330 Ft. from N. Line

\_\_\_\_\_ Ft. from S. Line

\_\_\_\_\_ Ft. from E. Line

330 Ft. from W. Line

Location \_\_\_\_\_

Rig up \_\_\_\_\_

Drilling and Remarks:

B.R.R.

**RECORD**

Cased \_\_\_\_\_ in., \_\_\_\_\_ ft.

Sand \_\_\_\_\_

Gas \_\_\_\_\_

Oil \_\_\_\_\_

Total Depth \_\_\_\_\_

**PRODUCTION**

1st 24 hrs. Nat. \_\_\_\_\_

1st 24 hrs. after shot \_\_\_\_\_

Gas \_\_\_\_\_ Cu. Ft.

Dry Hole \_\_\_\_\_

Abandoned \_\_\_\_\_

Date

**MAY 12 1937** 19

**H. D. Hatfield**

Scout

**KANSAS** *Summer*

Map No. 31 Sec. 4 Twp. 32 R. 1 W

Well No. 4-Rothrock

Stelbar Company

Contractor

**COMPLETED**

**SECTION PLAT**

530 Ft. from N. Line  
\_\_\_\_\_ Ft. from S. Line  
\_\_\_\_\_ Ft. from E. Line  
330 Ft. from W. Line

		0	

Location \_\_\_\_\_

Rig up \_\_\_\_\_

Drilling and Remarks:

*3000 Acid*

*flowed  
Pot 1565*

**RECORD**

Cased 7 in., 3650 ft.

Sand Chat 3650

Gas \_\_\_\_\_

Oil \_\_\_\_\_

Total Depth 3691

**PRODUCTION**

1st 24 hrs. Nat. \_\_\_\_\_

1st 24 hrs. after shot \_\_\_\_\_

Gas \_\_\_\_\_ Cu. Ft.

Dry Hole \_\_\_\_\_

Abandoned \_\_\_\_\_

Date

**JUN 16 1937** 19

**H. D. Hatfield**

Scout