


Section 4 Township 32 Range 1-W

Well Number 5 Rothrock

Company Continental

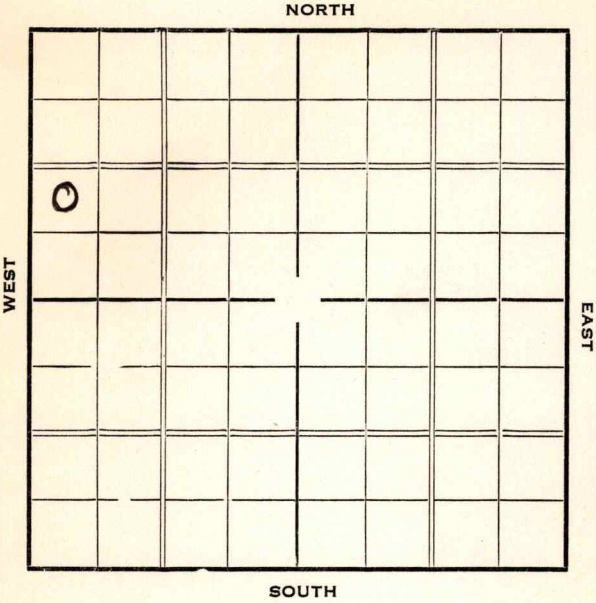

Sec. 4 Twp. 32 R. 1-W

Well No. #5 Rothrock Farm

Continental Company


_____Ft. from N. Line

990 Ft. from S. Line

_____ Ft. from E. Line

330 Ft. from W. Line

Elev. 1242

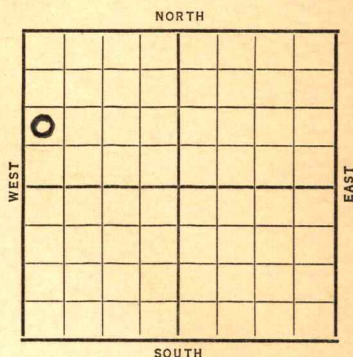

Date	REPORT
1937	
4/21	Location
4/30	"
5/7	R igg . up
5/14	" "
5/21	10" @ 360'. Drlg. 1860'.
5/28	Drlg. 3470'.
6/4	Chat & 7" @ 3649'.
	RUST.
6/11	Chat & 7" @ 3647' (Corrected)
	Drlg. 3685'.
6/19	T.D. 3687' S.W.
	P.B. 3682'. 1500' fluid.
	1000 acid.
6/25	2000 acid.
7/2	" "
7/9	T.D. 3686'.
7/16	" "
7/23	" "
	OVER

1937

7/28

Chat 3647' (corrected)

7" @ 3647'

TD 3687' (S.W.)

PB to 3682'

Drilled out plug to 3686'

3000 acid

(Minimum Well)

15 bbls per day.

COMPLETED

KANSAS *Summer*Map No. 31 Sec. 4 Twp. 32 R. 14Well No. 5 RotherickContinental Company

Contractor

SECTION PLAT

0			

 Ft. from N. Line990 Ft. from S. Line Ft. from E. Line330 Ft. from W. Line**FIRST REPORT**Location ✓Rig up

Drilling and Remarks:

RECORDCased in., ft.Sand Gas Oil Total Depth **PRODUCTION**1st 24 hrs. Nat. 1st 24 hrs. after shot Gas Cu. Ft.Dry Hole Abandoned

Date

APR 21 1937

19

S. J. LEWIS

Scout

Map No. 31 Sec. 4 Twp. 32 R. 1WWell No. 5 - RothrockContinental Company

Contractor

COMPLETED**SECTION PLAT** Ft. from N. Line990 Ft. from S. Line Ft. from E. Line330 Ft. from W. Line

0			

Location Rig up

Drilling and Remarks:

P.B. 3682drilled out Plug ToT.D. 36863000 Acid(Minimum well)15 bbls per day**RECORD**Cased 7 in., 3647 ft.Sand Chat 3647Gas (corrected)Oil Total Depth 3687 (sw)**PRODUCTION**1st 24 hrs. Nat. 1st 24 hrs. after shot Gas Cu. Ft.Dry Hole Abandoned

Date

JUL 28 1937 19H. D. Hatfield Scout