


Section 4 Township 32 Range 1W


Well No. 10 Rothrock

Company C R A et al

Misc.  
NORTH

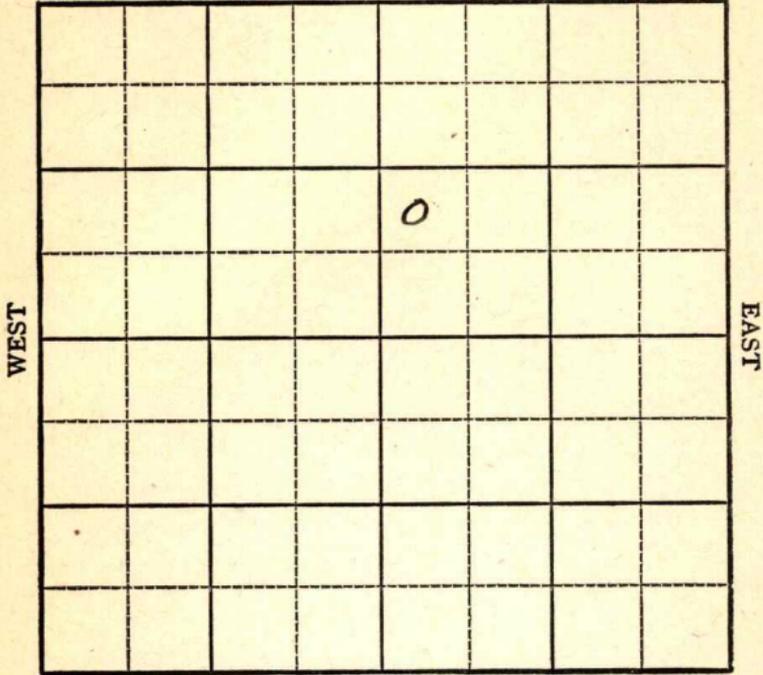

SOUTH

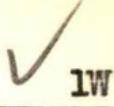

KANSAS

Sec. 4 Twp. 32 R. 1W

Well No. #10 Rothrock Farm  
C R A et al

Miscellaneous \_\_\_\_\_ Company


\_\_\_\_\_ Ft. from N. Line

990' Ft. from S. Line

\_\_\_\_\_ Ft. from E. Line

330' Ft. from W. Line

NW SW NE

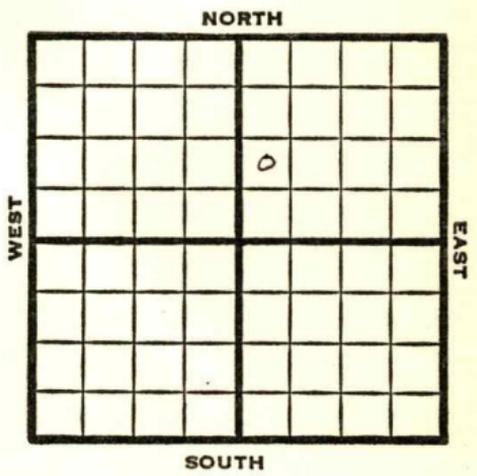

1948

**Eli 1243**

REPORT

- 10/27 RUR
- 11/3 8" @ 150'  
Drlg 1020'
- 11/10 **Stalnacker 2660'**  
**KC 3025'**  
Drlg 3225'
- 11/16 **Miss 3655'**  
TD 3663'  
5" @ 3662'
- 11/23 "
- 11/30 TD 3714'  
800 oil 30 hrs.
- 12/6 4000 acid
- 12/15 TD 3714'  
**Miss 3655'**  
5" @ 3662'  
4000 acid  
Pump 42 oil Pot  
39° Gr.  
Comp

**COMPLETED**

Map No. \_\_\_\_\_ Sec. 4 Twp. 32 R. 1W

Well No. 10 Rothrock

C R A etal. Company

FIRST REPORT Contractor

NW SW NE

SECTION PLAT

\_\_\_\_\_ Ft. from N. Line

990 Ft. from S. Line

\_\_\_\_\_ Ft. from E. Line

330 Ft. from W. Line

		◊	

Sumner County

Location \_\_\_\_\_

Rig up \_\_\_\_\_

Drilling and Remarks:

R UR

RECORD

Cased \_\_\_\_\_ in., \_\_\_\_\_ ft.

Sand \_\_\_\_\_

Gas \_\_\_\_\_

Oil \_\_\_\_\_

Total Depth \_\_\_\_\_

PRODUCTION

1st 24 hrs. Nat. \_\_\_\_\_

1st 24 hrs. after shot \_\_\_\_\_

Gas \_\_\_\_\_ Cu. Ft.

Dry Hole \_\_\_\_\_

Abandoned \_\_\_\_\_

Date

OCT 27 1948 19

S. J. LEWIS Scout

