


Section 5 Township 32 Range 1-W


Well Number 6- carr

Company Texas

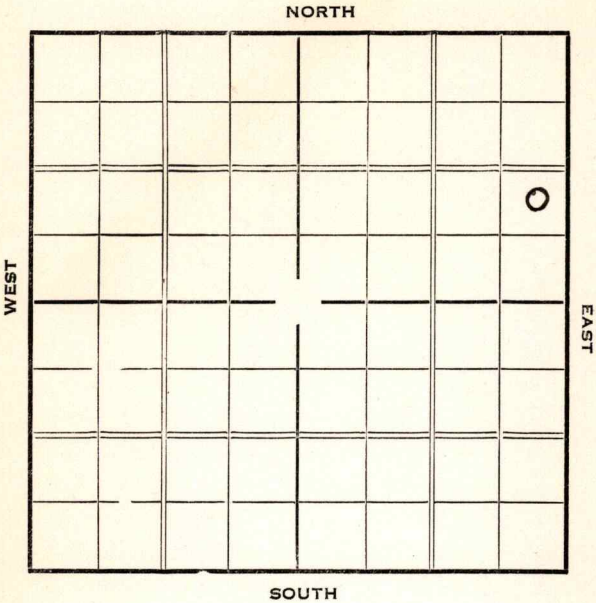

Sec. 5 Twp. 32 R. 1-WWell No. 6 - Carr FarmTexas Company Ft. from N. Line990 Ft. from S. Line330 Ft. from E. Line Ft. from W. Line

Elev. 1235

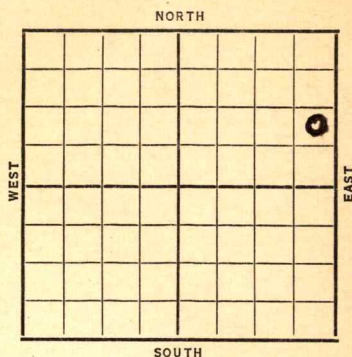

Date	REPORT
1937	
4/28	Cellar
5/7	"
5/14	R. R.
5/21	"
5/28	10" @ 250'. WOC.
6/4	Drlg. 2700'.
6/11	Drlg. 2831'.
6/19	Chat 3648'. 8" @ 3651'.
	T.D. 3652'. RUST.
6/25	T.D. 3693'. 500' oil.
7/2	3000 acid.
7/7	8" @ 3651'.
	Chat 3648'.
	T.D. 3693'.
	3000 A.
	Pot. 448 bbls.
	COMPLETED

Summer **KANSAS**Map No. _____ Sec. 5 Twp. 32 R. 1 WWell No. 6-CanTexas Company

Contractor

FIRST REPORT**SECTION PLAT**

			0

_____ Ft. from N. Line

990 Ft. from S. Line330 Ft. from E. Line

_____ Ft. from W. Line

Location _____

Rig up _____

Drilling and Remarks:

Cellar**RECORD**

Cased _____ in., _____ ft.

Sand _____

Gas _____

Oil _____

Total Depth _____

PRODUCTION

1st 24 hrs. Nat. _____

1st 24 hrs. after shot _____

Gas _____ Cu. Ft.

Dry Hole _____

Abandoned _____

Date

APR 28 1937

19

H. D. Hatfield Scout

KANSASMap No. 31 Sec. 5 Twp. 32 R. 1^WWell No. 6-CarrTexas Company

Contractor

COMPLETED**SECTION PLAT**

_____ Ft. from N. Line

990 Ft. from S. Line330 Ft. from E. Line

_____ Ft. from W. Line

Location _____

Rig up _____

Drilling and Remarks:

3000 APlot 448**RECORD**Cased 8 in., 365 ft.Sand Chat 3648

Gas _____

Oil _____

Total Depth 3693**PRODUCTION**

1st 24 hrs. Nat. _____

1st 24 hrs. after shot _____

Gas _____ Cu. Ft.

Dry Hole _____

Abandoned _____

Date

JUL 7 1937 19

H. D. Hatfield Scout