

Summer


FORM 51 IOM 12-46 PETROL

KANSAS

Section 5 Township 32 Range 1W

Well No. 8 Carr

Company Texas

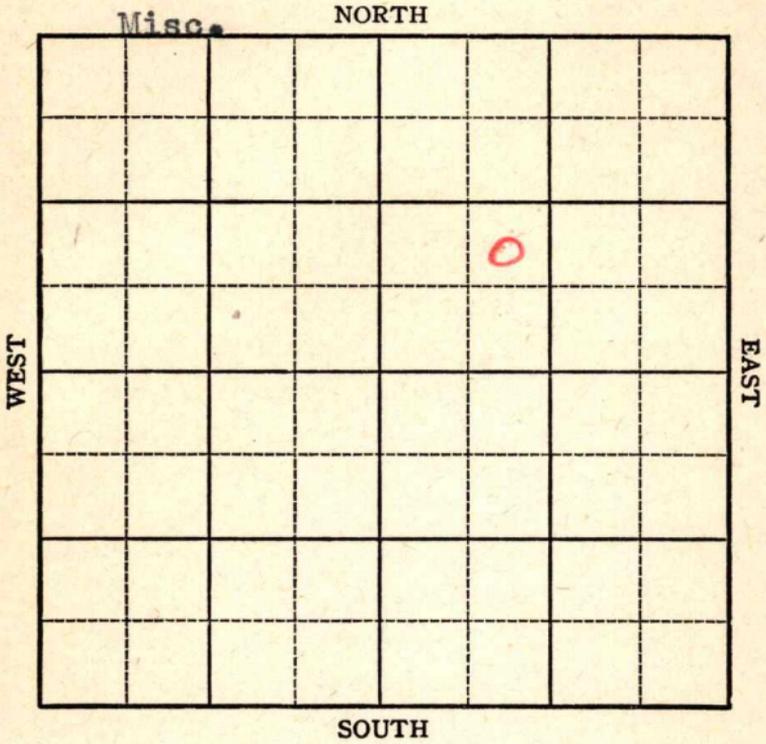

Sec. 5 Twp. 32 R. 1-W

Well No. #8 Carr Farm _____

Texas Company _____

Miscellaneous


_____ Ft. from N. Line

990 _____ Ft. from S. Line

_____ Ft. from E. Line

990 _____ Ft. from W. Line

NE SW NE

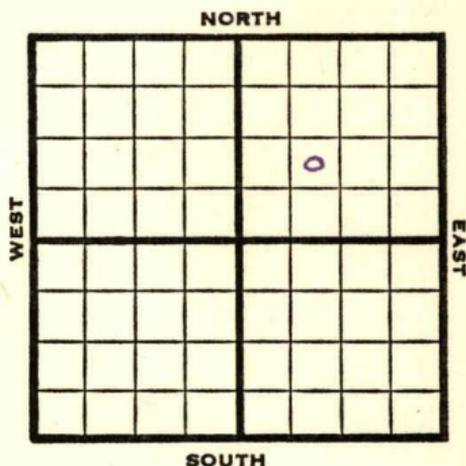

1947

Elev. 1226' REPORT

6/18 R U R

6/24 "

7/1 10" @ 350'
Drlg 1032'

7/8 Drlg. 3084'
KC 3026'

7/16 **Miss. 3630'**
T.D. 3632'
Run csg.

7/22 7" @ 3631
TD 3691

7/29 3000 Acid

8/6 **Miss. 3630'**
T.D. 3701'
Abandoned

ABANDONED

Map No. _____ Sec. 5 Twp. 32 R. 1W

Well No. 8 Carr

Texas

Company _____

FIRST REPORT

Contractor _____

NE SW NE

SECTION PLAT

_____ Ft. from N. Line

990 Ft. from S. Line

_____ Ft. from E. Line

990 Ft. from W. Line

		o	

Sumner County

Location _____

Rig up _____

Drilling and Remarks:

R U R

RECORD

Cased _____ in., _____ ft.

Sand _____

Gas _____

Oil _____

Total Depth _____

PRODUCTION

1st 24 hrs. Nat. _____

1st 24 hrs. after shot _____

Gas _____ Cu. Ft.

Dry Hole _____

Abandoned _____

Date

JUN 18 1947 19

S. J. LEWIS Scout

