


Section 5 Township 32 Range 1-W

Well No. 2 - Nelson

Company Amerada

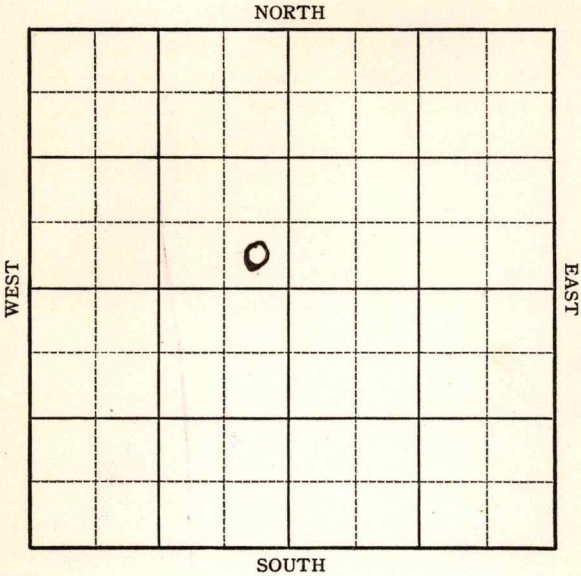

Map No. 31 Sec. 5 Twp. 32 R. WWell No. 2- NelsonAmerada Company

Contractor

FIRST REPORT**SECTION PLAT**

	0		

140 Ft. from N. Line330 Ft. from S. Line330 Ft. from E. Line

_____ Ft. from W. Line

Location _____

Rig up _____

Drilling and Remarks:

R. U. R**RECORD**

Cased _____ in., _____ ft.

Sand _____

Gas _____

Oil _____

Total Depth _____

PRODUCTION

1st 24 hrs. Nat. _____

1st 24 hrs. after shot _____

Gas _____ Cu. Ft.

Dry Hole _____

Abandoned _____

Date

JUN 2 1937 19H. D. Hatfield

Scout

Summer **KANSAS**Map No. 31 Sec. 5 Twp. 32 R. 1 WWell No. 2 - NelsonAmerada

Company

Contractor

COMPLETED**SECTION PLAT** Ft. from N. Line330 Ft. from S. Line330 Ft. from E. Line Ft. from W. Line

	0		

Location Rig up

Drilling and Remarks:

4000 Acid524 oil24 wat**RECORD**Cased 7 in., 3647 ft.Sand Chat 3647Gas (corrected)Oil Total Depth 3689**PRODUCTION**1st 24 hrs. Nat. 1st 24 hrs. after shot Gas Cu. Ft.Dry Hole Abandoned

Date

JUL 14 1937

19

H. D. Hatfield Scout