


Section 5 Township 32 Range 1-W

Well Number #1 White

Company Rose Spring Dlg.

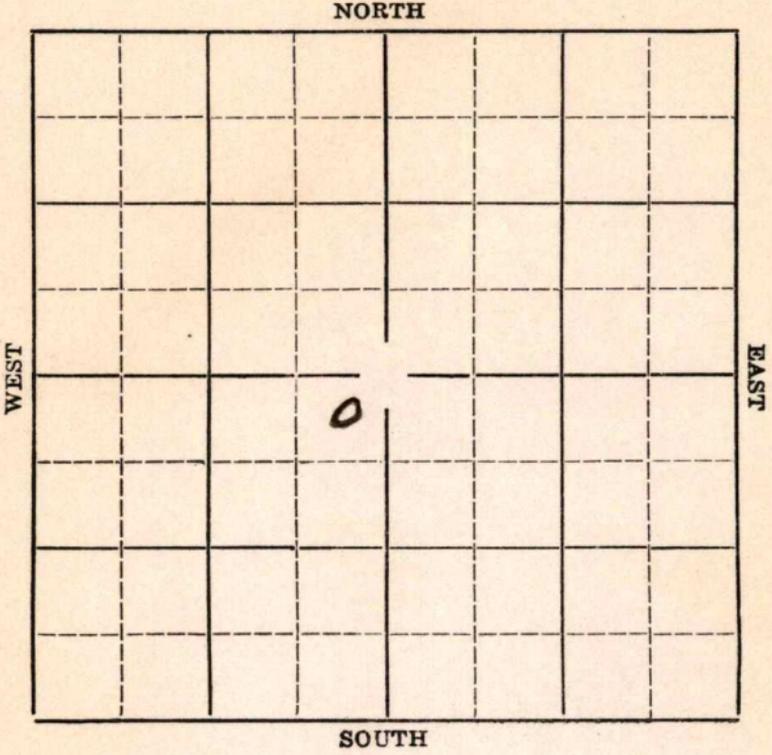


Sec. 5 Twp. 32 R. 1W

Well No. #1 White Farm

Rose Spring Drlg. Company

NORTH

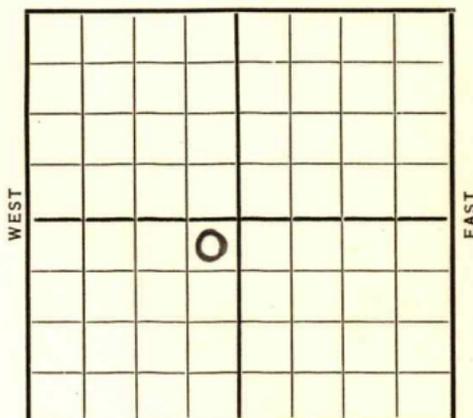

SOUTH

330' Ft. from N. Line

_____ Ft. from S. Line

330' Ft. from E. Line

_____ Ft. from W. Line

Elev 1218

~~DATE~~

REPORT

10/7 Cellar.

10/15--

10/22 Rig.

10/29 Surface hole.

11/6 12" @ 361 Drlg. 2100

11/12 **Kansas City 3018 Drlg. 3644**

11/19 ~~Chat 3650'~~ set 6" WOC

11/27---

12/1 Top Chat 3650

T.D. 3695

500 feet fluid in hole 9 hours

50 per cent water

Plugging back to 3690

Will run tubing and acidize (Tel)

12/10 1000 acid. No test.

12/17 Installing pumping unit.

OVER

1937

1/6 Chat 3650'. T. D. 3695'.

P.B. 3688'. 1000 acid.

50 bbls. oil. 150 water.

COMPLETED


Map No. 31 Sec. 5 Twp. 32 R. 1W

Well No. 1 White Farm

Rose Spring Drlg Company

Date Started _____ Ft. from N 330 S 330 E 330 W line

NORTH

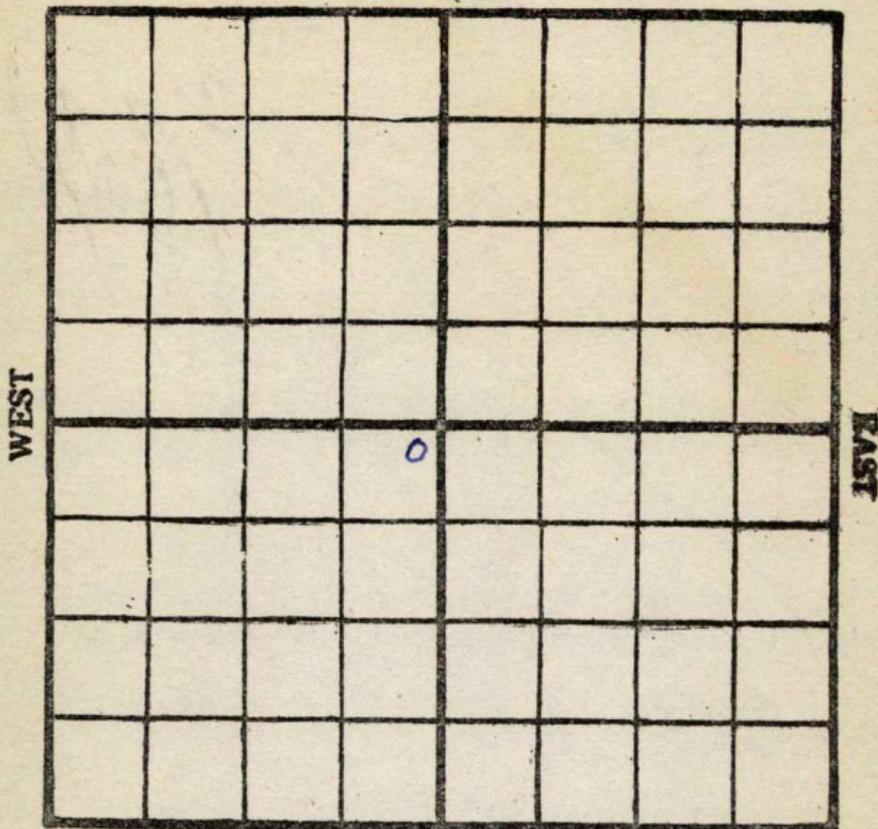

SOUTH

Cased _____ In. _____ Ft.

Sand _____

Pay { Gas _____
Oil _____

Total Depth _____

Production Remarks

Ocellar

Condition of Well on this date _____

FIRST REPORT

OCT 7 1936

S. J. LEWIS

Scout

Map No. 31 Sec. 5 Twp. 32 R. 14

Well No. 19 White

Rose Spring Drilling Company
Contractor

SECTION PLAT

	0		

330 Ft. from N. Line
_____ Ft. from S. Line
330 Ft. from E. Line
_____ Ft. from W. Line

COMPLETED

Location _____

Rig up _____

Drilling and Remarks:

Chad 3650
P.A 3688
1000 acid
50 lbs oil
150 " water

RECORD

Cased _____ in., _____ ft.
Sand _____
Gas _____
Oil _____
Total Depth 3695

PRODUCTION

1st 24 hrs. Nat. _____
1st 24 hrs. after shot _____
Gas _____ Cu. Ft.
Dry Hole _____
Abandoned _____

Date

JAN 6 1937 19

S. J. LEWIS Scout