


KANSAS

Section 5 Township 32 Range 1W

Well No. 2 Stone

Company Stelbar

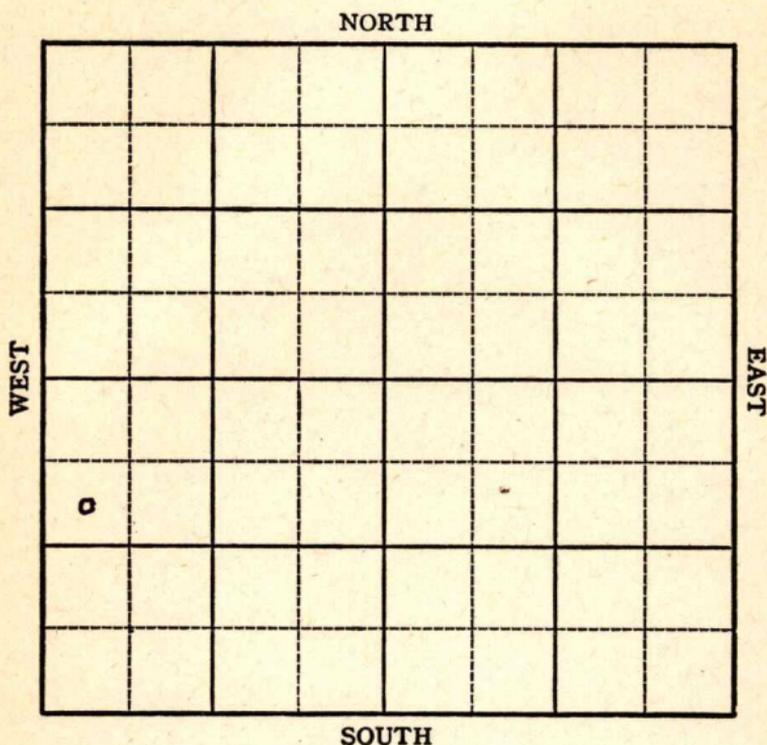

Sec. 5 Twp. 32 R. 1-W ✓

Well No. #2 Stone Farm

Stelbar Company


Miscellaneous

990 Ft. from N. Line

\_\_\_\_\_ Ft. from S. Line

\_\_\_\_\_ Ft. from E. Line

330 Ft. from W. Line

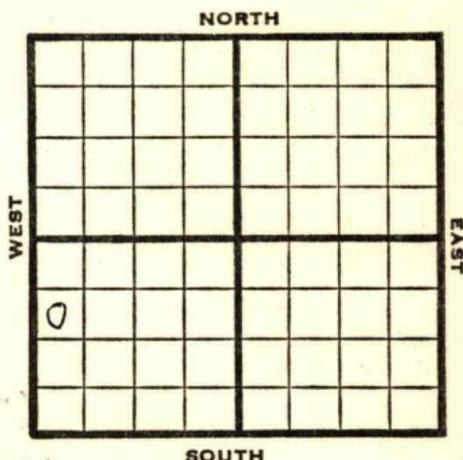

SW NW SW

Elev. 1206'

REPORT

1947

3/5 RUR

3/11 8" @ 139'  
Drlg 1548'

3/18 Drlg 2480'

3/25 **Chab 3631-40**  
TD 3640'  
5" @ 3640'

4/2 TD 36 83' 5000 Acid

4/9 " "

4/15 " "

4/23 Swab 10 oil and 4 W in 24 hrs.

4/29 " " "

5/7 **Chat 3631'**  
5" @ 3640  
TD 3683'

**ABANDONED**

Map No. 31 Sec. 5 Twp. 32 R. 1W

Well No. 2 Stone

Stelbar Company

**FIRST REPORT**

Contractor

SW NW SW

**SECTION PLAT**

990 Ft. from N. Line

\_\_\_\_\_ Ft. from S. Line

\_\_\_\_\_ Ft. from E. Line

330 Ft. from W. Line

o			

Sumner County

Location \_\_\_\_\_

Rig up \_\_\_\_\_

Drilling and Remarks:

R U R

**RECORD**

Cased \_\_\_\_\_ in., \_\_\_\_\_ ft.

Sand \_\_\_\_\_

Gas \_\_\_\_\_

Oil \_\_\_\_\_

Total Depth 330

**PRODUCTION**

1st 24 hrs. Nat. \_\_\_\_\_

1st 24 hrs. after shot \_\_\_\_\_

Gas \_\_\_\_\_ Cu. Ft.

Dry Hole \_\_\_\_\_

Abandoned \_\_\_\_\_

Date

MAR 5 1947 19

S. J. LEWIS Scout

KANSAS

Map No. A31 Sec. 5 Twp. 32 R. 1W

Well No. 2 Stone

Stelbar Company

**ABANDONED**

Contractor

SW NW SW

*E11206*

**SECTION PLAT**

990 Ft. from N. Line

         Ft. from S. Line

         Ft. from E. Line

330 Ft. from W. Line

6			

Sumner County

Location \_\_\_\_\_

Rig up \_\_\_\_\_

Drilling and Remarks:

*Chat 3631*  
*5-11-3640*

**RECORD**

Cased \_\_\_\_\_ in., \_\_\_\_\_ ft.

Sand \_\_\_\_\_

Gas \_\_\_\_\_

Oil \_\_\_\_\_

Total Depth 1865

**PRODUCTION**

1st 24 hrs. Nat. \_\_\_\_\_

1st 24 hrs. after shot \_\_\_\_\_

Gas \_\_\_\_\_ Cu. Ft.

Dry Hole \_\_\_\_\_

Abandoned \_\_\_\_\_

Date

MAY 7 1947 19

S. J. LEWIS Scout