

Summer

KANSAS

FORM 51 IOM 12-46 PETROL


Section 5 Township 32 Range 1-W

Well No. #3 Stone

Company Stelbar

Miscellaneous

NORTH

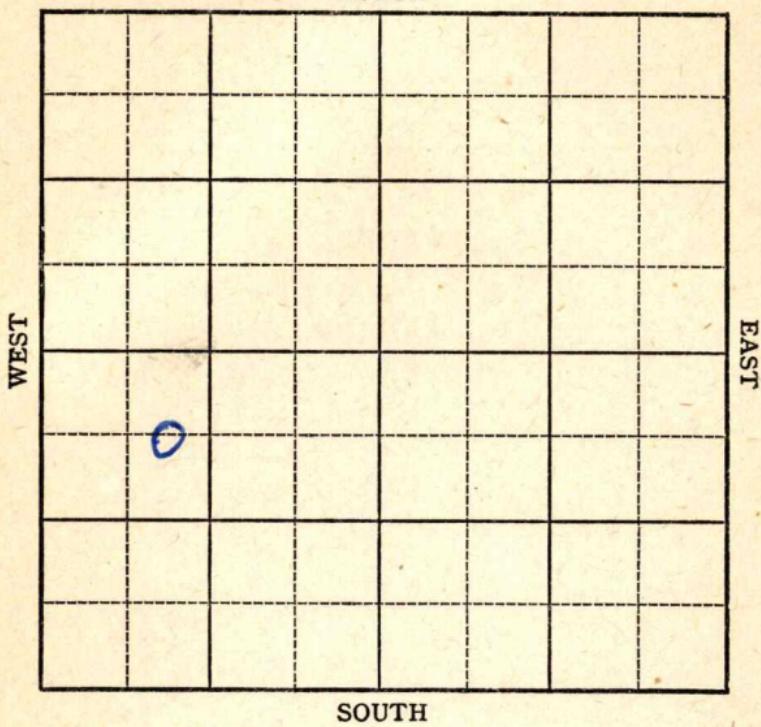

Sec. 5 Twp. 32 R. 1-W

Well No. 3 Stone Farm

Stelbar Company


Miscellaneous

660 Ft. from N. Line

Ft. from S. Line

Ft. from E. Line

990 Ft. from W. Line

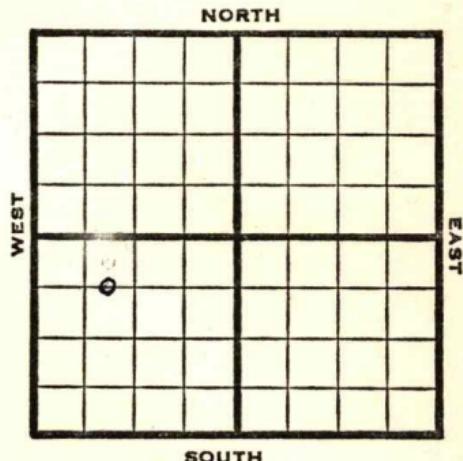

C E L NW SW

1947 ELEV. 1208' REPORT

8/20	Loc.
8/27	8" @ 144' Drlg. 980'
9/3	Drlg. 3177'
9/10	Chat 3642' TD 3645' 5" @ 3644' RUST
9/17	"
9/24	Chat 3642' 5" @ 3644' 5000 acid Pump 75 Pot 40.0 Gr. TD 3691'

COMPLETED

Map No. _____ Sec. 5 Twp. 32 R. 1W

Well No. 3 Stone


Stelbar Company

1ST REPORT

Contractor

C E L NW SW

SECTION PLAT

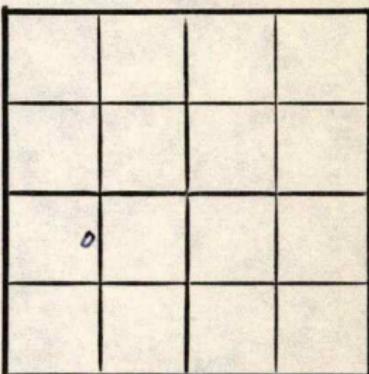

Sumner County

Location X

RECORD

Cased in., ft.

Sand

Gas

Oil

Total Depth

PRODUCTION

1st 24 hrs. Nat.

1st 24 hrs. after shot

Gas Cu. Ft.

Dry Hole

Abandoned

Date

AUG 20 1947

19

S. J. LEWIS Scout

Map No. 31 Sec. 5 Twp. 32 R. 1WWell No. 3 Stone


Stelbar

Company

COMPLETE

Contractor

C E L NW SW

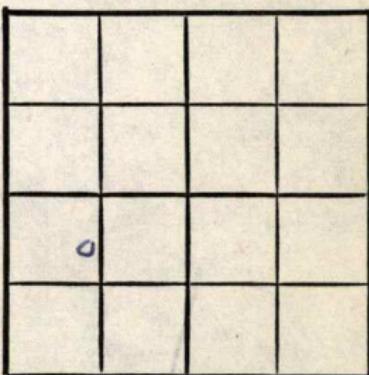E1,1208
SECTION PLAT660 Ft. from N. Line Ft. from S. Line Ft. from E. Line990 Ft. from W. Line

Sumner County

Location

RECORD

Rig up

Cased in, ft.

Drilling and Remarks:

Sand

Chat 3642

Gas

5" @ 3644

Oil

5000 acid

Total Depth 3681

Pump 2508*

PRODUCTION

40% GR

1st 24 hrs. Nat.

Date

1st 24 hrs. after shot

Gas Cu. Ft.

Dry Hole

Abandoned