


KANSAS

Sumner county

Section 6 Township 32 Range 1-W

Well No. #1, Stone "A"

Company Stelbar

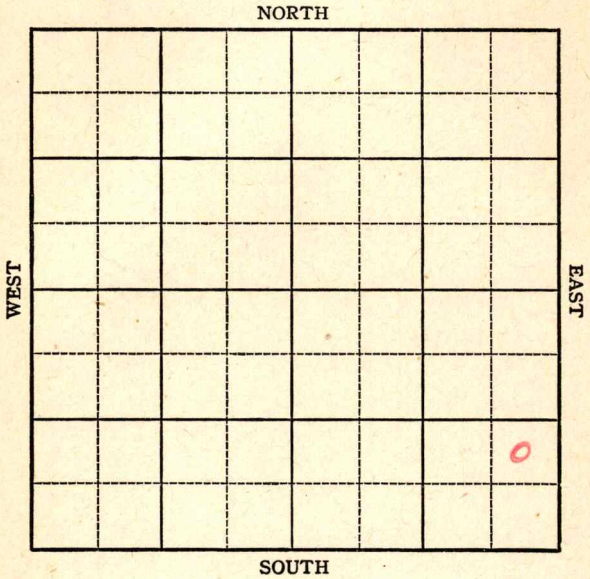

KANSAS

Sumner County ✓

Sec. 6 Twp. 32 R. 1W

Well No. 1 Stone "A" Farm _____

Stelbar Company _____


Miscellaneous

_____ Ft. from N. Line

990 Ft. from S. Line

330 Ft. from E. Line

_____ Ft. from W. Line

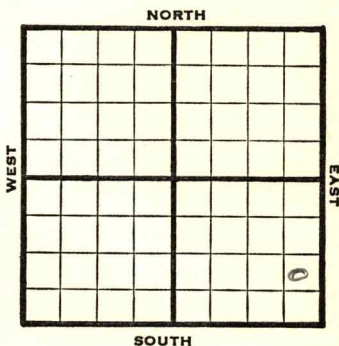

NE SE SE

REPORT

1947 **Elev. 1209**

1/2 10" @ 136'

Drlg 1730'

1/8 Drlg 2835'

1/15 Miss 3647

TD 49

5" @ 3649

RUST

1/21 Drlg 3659'

SD

1/29 TD 3691'

Miss 3647

5" @ 3649

5000 Acid

Pump 70 Pot

38 Gravity

COMPLETED

