

Summer


KANSAS

SECTION 7 TOWNSHIP 32 RANGE 1 W

WELL NO. #1 McDowell

COMPANY Stelbar Oil

NORTH

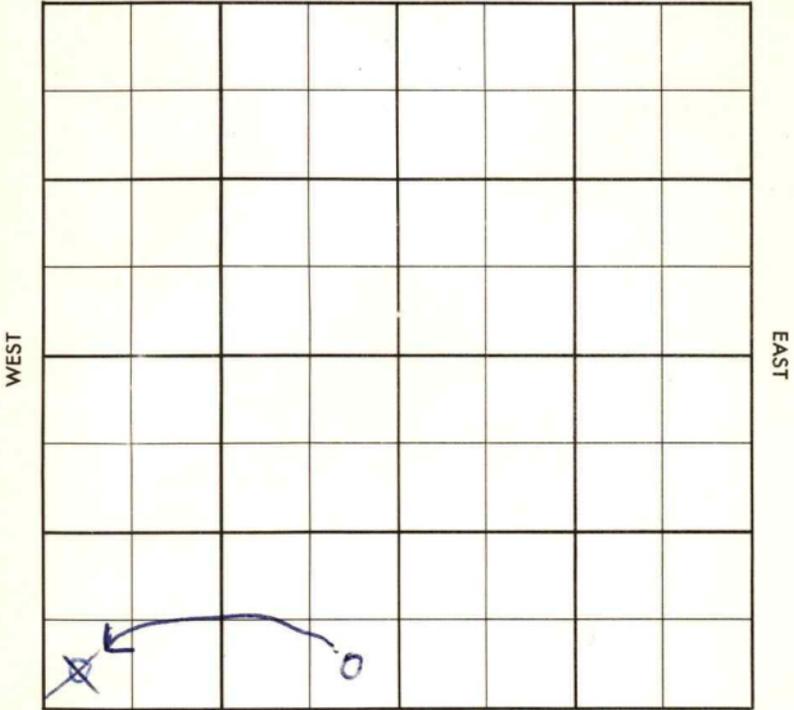

SOUTH

SEC. 7	TWP. 32	R. 1W
-----------	------------	----------

WELL NO.

#1 McDowell

FARM

COMPANY

Stelbar Oil

CONTRACTOR


_____ Ft. from N. Line

_____ Ft. from S. Line

_____ Ft. from E. Line

_____ Ft. from W. Line

~~SW SW SW~~
SE SE SW

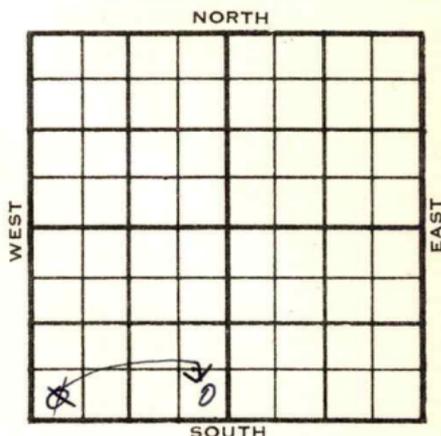

	ELEVATION	REPORT
1955	1272'	

12-14 MICT

1956

1- 11

Comm. 12-16-55
 8 5/8" @ 412/350
 DST 3255-74 op 1 hr. rec. 70' so&gcm
 120' so&gcw, 920/20"
 DST 3753-66 op 1 hr. rec. 25' mud,
 150/20"
 D & A
 Stal 2759
 KC. 3109
 Chert 3753
 Dolo. 3767
 TD 3795'

ABANDONED

CORRECTION

FORM 513 REV. SUNRAY

County Sumner Elev. _____
 Sec. 7 Twp. 32 Rge. 1W
 Company Stelbar Oil
 Farm Name McDowell No. 1

TOPS	DEPTH	LOG	DATUM	Loc. in Sec.
Anh.				SE SE SW
Tr.				
H.				
Tr.				
Dg.				
Bl.				
L.				Geol. _____
K.C.				Contr. _____
B.K.C.				
Ce.				
C.				
M.				Pool _____
M.				
K.				
Mz.				
Mq.				
V.				
S.				
S.				
A.				
R.				
Pe.				
G.				
T.D.				

CORRECTION

JAN 11 1956

Date Comm. Reported SW SW SW

Co.
Lse.
No.
Sec.
T.
R.

County Sumner Elev. 1272
 Sec. 7 Twp. 32 Rge. 1W
 Company Stelbar Oil
 Farm Name McDowell No. 1

TOPS	DEPTH	LOG	DATUM	Loc. in Sec.
Anh.				SE SE SW
Tr.				
H. <u>Stal</u>	<u>2759</u>		<u>1487</u>	
Dg.				
Bl.				
L.				
K.C.	<u>3109</u>		<u>1837</u>	Geol.
B.K.C.				Contr.
Ce.				
C.				
M. <u>Chert</u>	<u>3753</u>		<u>2481</u>	Pool
M. <u>dola</u>	<u>3767</u>		<u>2495</u>	
K.				
Mz.				
Mo.				
V.				
S.				
S.				
A.				
R.				
Pc.				
G.				
T.D.	<u>3795</u>			



Date Comm. 12-16-55 JAN 11 1956
8 5/8" @ 412/350 DST 3 255-74
open 1 hr. rec. 70' so & gcm 120' so
& gcw 920/20" DST 3753-66 open 1 hr.
rec. 25' mud 150/20"
 D & A

Co.
Lse.
No.
Sec.
T.
R.

County Sumner Elev. _____
 Sec. 7 Twp. 38 Rge. 1W
 Company Stelbar Oil
 Farm Name McDowell No. 1

TOPS	DEPTH	LOG	DATUM	Loc. in Sec.
Anh.				SW SW SW
T.P.				
H.				
Tr.				
Dg.				
Bl.				
L.				Geol.
K.C.				Contr.
B.K.C.				
Ce.				
C.				
M.				Pool
M.				
K.				
Mz.				
Me.				
V.				
S.				
S.				
A				
R.				
Pe.				
G.				
T.D.				

FIRST REPORT
 DEC 14 '55
 0

Date Comm. MICT

[Handwritten signature]

Co.
Lse.
No.
Sec.
T.
R.