


11-32-10W

WELL LOG BUREAU—KANSAS GEOLOGICAL SOCIETY
508 East Murdock, Wichita, Kansas

Company- PICKRELL DRILLING COMPANY, ETAL
Farm- Slinker No. 1

SEC. 11- T. 32 R. 10W
NW NW NW

Total Depth. 4470' RTD
Comm. 4-30-56 Comp. 5-16-56
Shot or Treated.
Contractor. Pickrell Drlg. Co.
Issued. 8-11-56

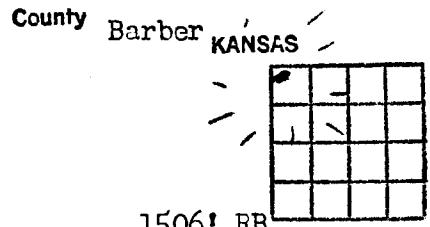

CASING:

8 5/8" csg. cem. w/135 sx. 160'
4 1/2" 146 Jts. J-55 w/85 sx cem at 4460'

Production. 8,800,000 CFG

Figures indicate Bottom of Formations.

MEASUREMENTS FROM TOP OF ROTARY BUSHING

red rock	160
shale & red rock	235
red rock	265
red bed shale & shells	955
shale & shells	1405
lime	2355
lime & shale	2545
shale	2645
lime & shale	3617
lime	4330
Mississippi Lime	4470 RTD
Total Depth	

TOPS:

Anhydrite	825
Heebner	3493
Douglas Shale	3542
Douglas Sand	3610
Lansing	3679
Mississippi	4335