

16-32-10W

AFFIDAVIT OF COMPLETION FORM WICHITA BRANCH

ACO-1

This form shall be filed in triplicate with the Kansas Corporation Commission, 200 Colorado Derby Building, Wichita, Kansas 67202, within ten days after the completion of the well, regardless of how the well was completed. Circle one: Oil, gas, dry SWD, OWWO, injection. Type and complete ALL sections. Applications must be filed for dual completion, commingling, salt water disposal and injection. Attach wireline logs (i.e. electrical log, sonic log, gamma ray neutron log, etc.) KCC#-(316)263-3238.

OPERATOR Herndon Oil and Gas Company

API NO. 15-007-21310

ADDRESS P.O. Box 489

COUNTY Barber

Tulsa, Oklahoma 74101

FIELD McGuire - Goemann

**CONTACT PERSON James H. Duck, Jr.

PROD. FORMATION None

PHONE (918) 743-5446

LEASE Blahut

PURCHASER None

WELL NO. 1

ADDRESS None

150' South, 60' East
WELL LOCATION of C-E/2 SW/4

DRILLING Union Drilling Company

1170 Ft. from South Line and

CONTRACTOR 422 Union Center Building

600 Ft. from East Line of


ADDRESS Wichita, Kansas 67202

the SW/4 SEC. 16 TWP. 32S RGE. 10W

PLUGGING Union Drilling Company

CONTRACTOR 422 Union Center Building

ADDRESS Wichita, Kansas 67202

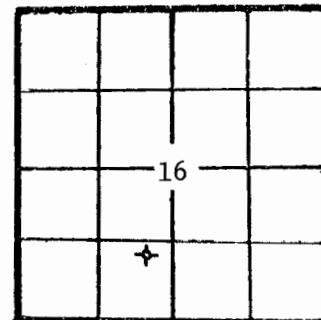

WELL FLAT

TOTAL DEPTH 4440' PBTD

KCC
KGS ☒
MISC
(Office Use)

SPUD DATE 10-27-81 DATE COMPLETED 11-3-81

ELEV: GR 1463' DF KB 1468'

DRILLED WITH (CABLE) ROTARY (AIR) TOOLS

New / (Used) casing.

CASING RECORD

Report of all strings set — surface, intermediate, production, etc.

Purpose of string	Size hole drilled	Size casing set (in O.D.)	Weight lbs/ft.	Setting depth	Type cement	Sacks	Type and percent additives
Surface	12 1/4"	8-5/8"	20#	278'	Common	250	2% Gel, 3% CC

LINER RECORD

PERFORATION RECORD

Top, ft.	Bottom, ft.	Sacks cement	Shots per ft.	Size & type	Depth interval
N/A			N/A		

TUBING RECORD

Setting depth Backer set at

W01-22-21

Name of lowest fresh water producing stratum Unknown Depth 74'

Estimated height of cement behind Surface Pipe cement circulated.

DV USED? No

16-32-10W

WELL LOG

Formation Description, Contents, etc.	Top	Bottom	Name	Depth
			Heebner	3491'
			Lansing	3675'
			Swope	4106'
			Hertha	4131'
			Pawnee	4279'
			Ft. Scott	4308'
			Cherokee	4328'
			Mississippi Lm	4384'
			Total Depth	4440'

A F F I D A V I T

STATE OF Oklahoma, COUNTY OF Tulsa SS, James H.

Duck, Jr. OF LAWFUL AGE, BEING FIRST DULY SWORN UPON HIS OATH,

DEPOSES THAT HE IS Vice President (FOR) OF Herndon Oil and Gas Company

OPERATOR OF THE Blahut LEASE, AND IS DULY AUTHORIZED TO MAKE