

Inc

STATE CORPORATION COMMISSION OF KANSAS
OIL & GAS CONSERVATION DIVISION
WELL COMPLETION OR RECOMPLETION FORM
ACO-1 WELL HISTORY
DESCRIPTION OF WELL AND LEASE

S

API NO. 15-007-22,151
County Barber
C... NW NW Sec. 22 Twp. 32 Rge. 10 East
W West

4620
4620
Ft North from Southeast Corner of Section
Ft West from Southeast Corner of Section
(Note: Locate well in section plat below)

Lease Name... Eck Well #... 1

Field Name... McGuire-Goeman

Producing Formation... Mississippian

Elevation: Ground... 1455 KB... 1460

Operator: License # 5003
Name McCoy Petroleum Corporation
Address 110 S. Main, Suite 500
City/State/Zip Wichita, Kansas 67202

Purchaser... Peoples Natural Gas
Wichita, Kansas

Operator Contact Person Rager McCoy
Phone 316-265-9697

Contractor: License # 5418
Name Allen Drilling Company

Wellsite Geologist Kevin McCoy
Phone 316-265-9697

Designate Type of Completion
 New Well Re-Entry Workover

Gas Dry
 SWD Inj Temp Abd
 Delayed Comp. Other (Core, Water Supply etc.)

If OWWO: old well info as follows:
Operator
Well Name
Comp. Date Old Total Depth

WELL HISTORY


Drilling Method:
 Mud Rotary Air Rotary Cable

4-6-87 4-16-87 7-11-87
Spud Date Date Reached TD Completion Date

4690' 4622'
Total Depth PBTD

Amount of Surface Pipe Set and Cemented at 283 feet
Multiple Stage Cementing Collar Used? Yes No
If yes, show depth set... feet
If alternate 2 completion, cement circulated from... feet depth to... w/... SX cmt
Cement Company Name

Section Plat

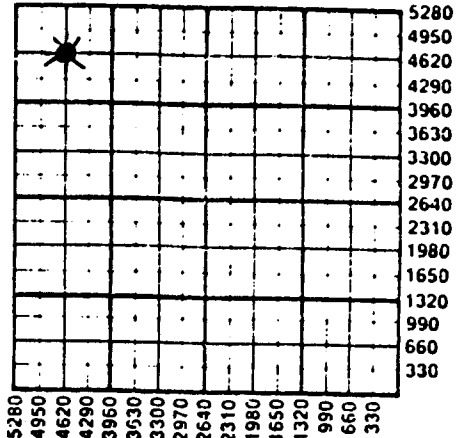

WATER SUPPLY INFORMATION

Disposition of Produced Water: Disposal
Docket # D-21250 Repressuring

Questions on this portion of the ACO-1 call:

Water Resources Board (913) 296-3717

Source of Water:
Division of Water Resources Permit #

Groundwater... Ft North from Southeast Corner
(Well) ... Ft West from Southeast Corner of
Sec Twp Rge East West

Surface Water 4520 Ft North from Southeast Corner
(Stream, pond etc.) 4620 Ft West from Southeast Corner
Sec Twp Rge East West

Estimated Production Per 24 Hours	Oil	Gas	Water	Gas-Oil Ratio	Gravity
17.53 Bbls	143 MCF	219 Bbls	8157 CFPB		

METHOD OF COMPLETION

Production Interval

Disposition of gas: Vented Sold Used on Lease
 Open Hole Perforation Other (Specify) Drilling Completed

4360-4375'

Mississippian

SIDE TWO

Operator Name McCoy Petroleum Corporation Lease Name Eck Well # 1

Sec. 22 Twp. 32S Rge. 10 East West County Barber

WELL LOG

INSTRUCTIONS: Show important tops and base of formations penetrated. Detail all cores. Report all drill stem tests giving interval tested, time tool open and closed, flowing and shut-in pressures, whether shut-in pressure reached static level, hydrostatic pressures, bottom hole temperature, fluid recovery, and flow rates if gas to surface during test. Attach extra sheet if more space is needed. Attach copy of log.

Drill Stem Tests Taken Yes No
 Samples Sent to Geological Survey Yes No
 Cores Taken Yes No

Formation Description
 Log Sample

See Attached Sheet

Name	Top	Bottom
Heebner	3464	(-2004)
Lansing	3645	(-2145)
Kansas City	3940	(-2480)
Stark	4084	(-2624)
Cherokee	4314	(-2854)
Mississippian	4359	(-2855)
Kinderhook	4566	(-3106)
Viola	4650	(-3190)
LTD	4690	(-3230)

CASING RECORD <input checked="" type="checkbox"/> New <input type="checkbox"/> Used							
Report all strings set-conductor, surface, intermediate, production, etc.							
Purpose of String	Size Hole Drilled	Size Casing Set (in O.D.)	Weight Lbs/Ft.	Setting Depth	Type of Cement	#Sacks Used	Type and Percent Additives
Surface	12-1/4"	8-5/8"	24	283'	Common	175	2% gel 3% cc
Production	7-7/8"	4-1/2"	10.5	4685'	60-40 Pd 10% Gelsonite	175	2% gel 10% salt 75CFR-2
PERFORATION RECORD				Acid, Fracture, Shot, Cement Squeeze Record (Amount and Kind of Material Used)			
Shots Per Foot	Specify Footage of Each Interval Perforated			Depth			
2	4360-4375			Acid: 1000 gal 10% FE same Frac: 17,000 gal MY-T-GEL Lt same x 20,500# sand			
TUBING RECORD				Liner Run <input type="checkbox"/> Yes <input checked="" type="checkbox"/> No			
Date of First Production		Size Set At	Packer at				
		2-3/8" EUE 4355'	None				
Producing Method <input type="checkbox"/> Flowing <input checked="" type="checkbox"/> Pumping <input type="checkbox"/> Gas Lift <input type="checkbox"/> Other (explain).....							