


Barber

KANSAS

SECTION 13 TOWNSHIP 32 RANGE 10W

WELL NO. #1 Thompson

COMPANY Jones, Shelburne & Farmer

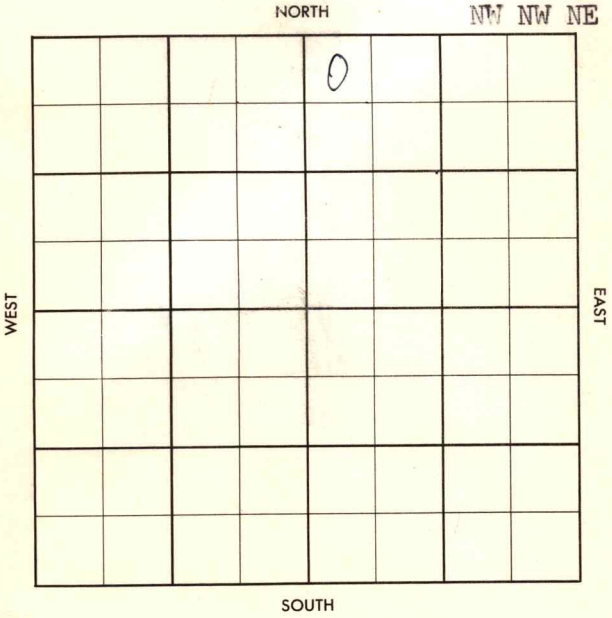

County Barber Elev. _____
 Sec. 13 Twp. 32 Rgs. LOW
 Company Jones, Shelburne & Farmer
 FarmName Thompson No. 1

TOPS	DEPTH	LOG	DATUM	Loc. in Sec.																
Anh.				NW NW NE																
TP.																				
H.																				
Tr.																				
Dg.																				
Bl.																				
L.				Geol. _____																
K.C.				Contr. _____																
B.K.C.				Co. Tools _____																
Ce.				Pool _____																
C.				Sharon																
M.				<table border="1"> <tr> <td></td> <td></td> <td>0</td> <td></td> </tr> <tr> <td colspan="4" style="text-align: center;">FIRST REPORT</td> </tr> <tr> <td></td> <td></td> <td></td> <td></td> </tr> <tr> <td colspan="4" style="text-align: center;">MAR 6 '57</td> </tr> </table>			0		FIRST REPORT								MAR 6 '57			
		0																		
FIRST REPORT																				
MAR 6 '57																				
M.																				
K.																				
Mz.																				
Me.																				
V.																				
S.																				
S.																				
A.																				
R.																				
PE.																				
G.																				
T.D.																				

Date Comm. 3-4-57
8" @ 208, W O C

~~27~~

Co.
Sec.
T.
R.

County Barber Elev. 1468
 Sec. 13 Twp. 32 Rge. 10W
 Company Jones, Shelburne & Farmer
 Farm Name Thompson No. 1

TOPS	DEPTH	LOG	DATUM	Loc. in Sec.																														
Anh.				NW NW NE																														
Tr.																																		
H.	3388																																	
Tr.																																		
Dg. <u>sd</u>	3523																																	
BL.																																		
L.	3600			Geol.																														
K.C.				Contr.																														
B.K.C.				Co. Tools																														
Ce.				Pool																														
C.				Sharon																														
M.	3355			<table border="1"> <tr><td></td><td></td><td></td></tr> <tr><td></td><td></td><td></td></tr> <tr><td></td><td></td><td></td></tr> <tr><td></td><td></td><td></td></tr> <tr><td></td><td></td><td></td></tr> <tr><td></td><td></td><td></td></tr> <tr><td></td><td></td><td></td></tr> <tr><td></td><td></td><td></td></tr> <tr><td></td><td></td><td></td></tr> <tr><td></td><td></td><td></td></tr> </table>																														
M.																																		
K.																																		
Mz.																																		
Ma.																																		
V.																																		
S.																																		
S.																																		
A.																																		
R.																																		
PE.																																		
G.																																		
TD.	4360																																	

Date Comm. 3-4-57
8" @ 208, W O C 3482
DST 4356-60 40" 6 1/2" ga
3.20 MCF/5" ga 2.190 MCF
120" ga 1.540 MCF/30" spray
oil 35" net 265' Free gassy
oil BHP 1720 5 1/2 4357
MAR 27 '57 APR 3 '57 CO DD 4363 TD
Flwd 19 Boph "1/16" ch.
CP 560# wo POT APR 10 '57 APR 17 '57
APR 24 '57

Flow 30 Boph no/w
 2" T69 19 Boph
 no/w 10/14" ch 6 hrs

FCL 750 5 MAY 1 '57 MAY 18 '57

MAY 15 '57 MAY 22 '57

Ph Flow 160

Bopd no/w to gran 31°