


Section 14 Township 32 Range 10W

Well No. #1 Hrencher

Company National Association Pet.

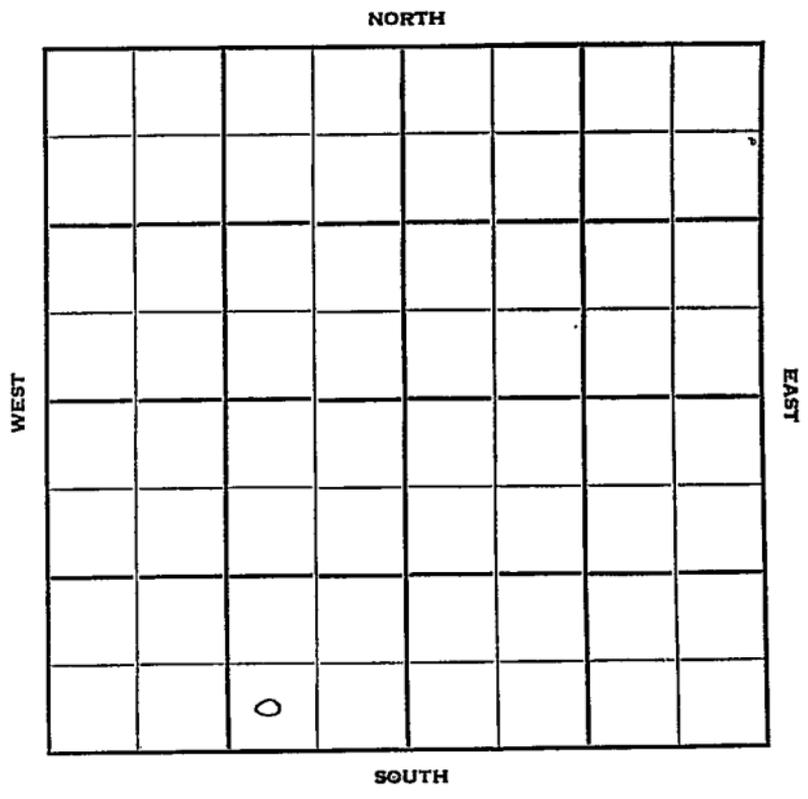

11-2-50

Sec. 14 Twp. 32 R. 10W

Well No. #1 Hrencher Farm

National Association Pet. Company

Benwick - Contr. Contractor

Wildcat


_____ Ft. from N. Line

330' Ft. from S. Line

990' Ft. from E. Line

_____ Ft. from W. Line

SW SE SW

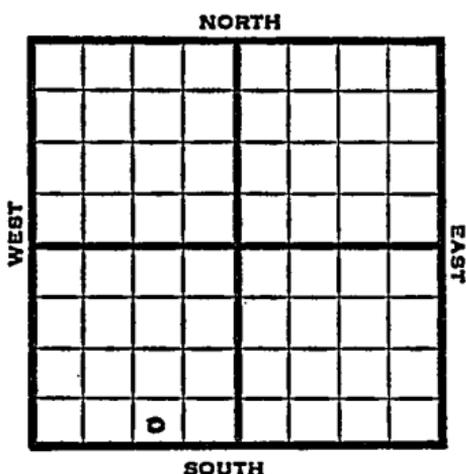

1951 Elev. 1460' REPORT

9/21 8" @ 300'
Drlg. 1400'
9-21-51

10/24 Spud 9-21-51
D & A TD 4950'
8" @ 300'
DST 4339-61, open 1½ hr. rec 15' mud
DST 4361-4400', open 1 hr. rec 180'
mud, 300' mud & water, 3100' SW.
DST 4434-41 open 1½ hr. rec 30' SOCM
30' SO & SWCM, 240' M & SW,
Lans. 3642' Misener 4466' Viola
4659'
DST 4667-94', open 45 min. rec 12' mud.
Simp. 4743' Arb. 4892'
TD 4950'
D & A

ABANDONED

