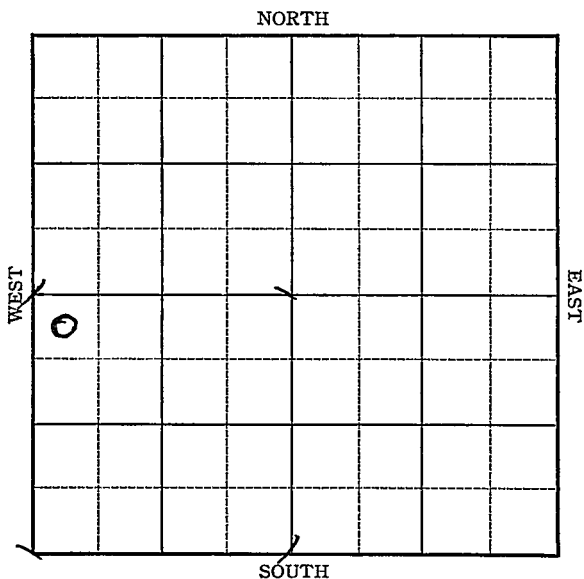


Section 16 Township 32 Range 10-WWell No. 1 WintersCompany Helmerich & Payne et al

Sec. 16 Twp. 32 R. 10-W

Well No. #1 Winters Farm

Helmerich & Payne et al Company


~~330~~ Ft. from N. Line

_____ Ft. from S. Line

_____ Ft. from E. Line

330 Ft. from W. Line

Special

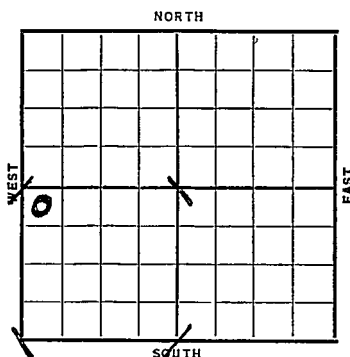

Date	Elev. 1470	REPORT
1937		
11/3	Cellar.	
11/12	R. R.	
11/19	"	
11/26	"	
12/3	"	
12/10	12" @ 105'. WOC.	
12/17	Drlg. 2200'.	
12/24	Drlg. 3450'.	
12/31	Drl g. 4025'.	
1938		
1/7	Chat 4353'. Dead Asphalt 4353- 4356'. Oil stains 4356-58 & 4368-73'. Drl g. 4420'.	
	No shows.	
1/12	Base Miss. 4580 Viola 4664 Show oil and gas at 4664-67 Wilcox 4768 Coring 4770 No show (Tel)	
		OVER

1938

1/19

Simp. 4751'.

Arb. 5000'.

T.D. 5125'.

No shows.

4664	4751
1470	1470
<u>3194</u>	<u>3281</u>

ABANDONED

Map No. 61 Sec. 16 Twp. 32 R. 10WWell No. 1-WintersHelmerich & Payne etal Company

Contractor

ABANDONED

NW SW

SECTION PLAT

0			

330 Ft. from N. Line Ft. from S. Line Ft. from E. Line330 Ft. from W. LineLocation Rig up

Drilling and Remarks:

Simp 4751
 Arb 5000
 T.D. 5125

No shows

D & A

RECORD

Cased in., ft.Sand Gas Oil Total Depth 5125

PRODUCTION

1st 24 hrs. Nat. 1st 24 hrs. after shot Gas Cu. Ft.Dry Hole Abandoned

Date

JAN 19 1938 19 H. D. Hatfield Scout

Map No. 61 Sec. 16 Twp. 32 R. 10WWell No. 1 WintersHelmerich & Payne etal Company

Contractor

FIRST REPORT

Gulf Farm-out


SECTION PLAT

NW SW

330 Ft. from N. Line

_____ Ft. from S. Line

_____ Ft. from E. Line

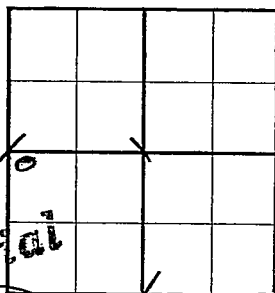330 Ft. from W. Line*Special*

Location _____

Rig up _____

Drilling and Remarks:
Cellar

RECORD

Cased _____ in., _____ ft.

Sand _____

Gas _____

Oil _____

Total Depth _____

PRODUCTION

1st 24 hrs. Nat. _____

1st 24 hrs. after shot _____

Gas _____ Cu. Ft.

Dry Hole _____

Abandoned _____

Date

NOV 3 1937 19

H. D. Hatfield

Scout