

Barber

KANSAS

SECTION 19 TOWNSHIP 32 RANGE 10W

WELL NO. #1 Davis-McReynolds Unit

COMPANY Mull & Magnolia

NORTH

						0	

WEST

EAST

SOUTH

Barber

KANSAS

SEC. 19	TWP. 32	R. 10W
------------	------------	-----------

WELL NO. #1 Davis McReynolds Unit FARM

COMPANY Mull & Magnolia

CONTRACTOR Mull Drlg.


**Wildcat**

\_\_\_\_\_ FT. FROM N. LINE

\_\_\_\_\_ FT. FROM S. LINE

\_\_\_\_\_ FT. FROM E. LINE

\_\_\_\_\_ FT. FROM W. LINE

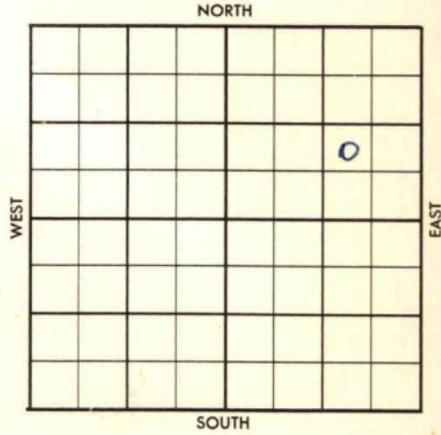

NW SE NE

1956	ELEVATION	REPORT
------	-----------	--------

9-5	MIR	
-----	-----	--

County Barber Elev. \_\_\_\_\_  
 Sec. 39 Twp. 32 Rge. LOW  
 Company Mull & Magnolia  
 Farm Name Davis-McReynolds Unit No. 1

TOPS	DEPTH	LOG	DATUM
Anh.			
TP.			
H.			
Tr.			
Dg.			
Bl.			
L.			
K.C.			
B.K.C.			
Ce.			
C.			
M.			
M.			
K.			
Mz.			
Me.			
V.			
S.			
S.			
A.			
R.			
PE.			
G.			
T.D.			

Loc. in Sec. NW SE NE  
 Geol. \_\_\_\_\_  
 Contr. Mull Drlg.  
 Pool Wildcat  
  
 FIRST REPORT  
 SEP 5 '56

Date Comm. M I R

*Handwritten:* 270  
*Handwritten:* M.I.R.  
*Handwritten:* SEP 11 1956

Co.  
 No.  
 Sec.  
 T.  
 R.

County Barber Elev. 1474  
 Sec. 39 Twp. 32 Rge. 10W  
 Company Mull & Magnolia  
 Farm Name Davis-McReynolds Unit No. 1

Co.  
Lse.  
No.  
Sec.  
T.  
R.

TOPS	DEPTH	LOG	DATUM
Anh.			
Tp.			
H.		3523	
Tr.			
Dg.			
BL.			
L.		3706	
K.C.			
B.K.C.			
Ce.			
C.			
M.	4388	4388	
M.			
K.			
Mz.			
Mq.			
V.			
S.			
S.			
A.			
R.			
PE.			
G.			
TD.	4425		

Loc. in Sec. NW SE NE  
 Geol. \_\_\_\_\_  
 Contr. Mull Drlg.  
 Pool Wildcat  
 COMPLETE

Date Comm. MIR SEP 12 '56 9-5-56 85/8 160  
1150 @ 3850 SEP 19 '56 DST 4392  
-4410 1hr G/3" ga 116 MCF  
in 15" rec 90' 56 GCM BHP  
1660/20 DST 4410-25 2 hrs  
G/2" ga 98 MCF 115" 145 MCF  
45" rec 95' 6 GCM BHP 1610  
RA9 5 1/2 @ 4425 CO SEP 26 '56  
CO 4425 60/ 4392-4402

84/4408-22 ga est 200

MCF-1/2 frac ga 7 To 8

Mill CFB. OCT 3 '56 OCT 10 '56 OCT 17 '56

OCT 24 '56 OCT 31 '56 NOV 7 '56 NOV 13 '56

op Flw 5,380 MCF GPD  
thro 2" Tbg.